

MISSISSIPPI DEPARTMENT OF NATURAL RESOURCES
Bureau of Land and Water Resources
Southport Mall
P.O. Box 10631
Jackson, Mississippi 39209
WATER WELL DRILLERS LOG

Harrison
N
2075

8-3-84 19 Mediap Well Works Harrison
date well completed firm name county well located

LANDOWNER: Chester Saxe

Rt. 4 Box 384

Pass Chr. Mo.
(mailing address)

WELL LOCATION:

sec 22 T 8 N R 13 E
2 miles W of PC.
(distance) (direction) (nearest town)

WELL PURPOSE:
(home, irrigation, municipal, industrial)

WELL COMPLETION DATA:

- (1) diameter (inches) 2"
- (2) total depth (feet) 215'
- (3) static water level (feet) 30' ^{below}/_{above} top of ground.
- (4) casing concrete, 205',
(material) (depth)
305'
(size) if telescope see back.
- (5) screen 10', 205'
(length) (depth to top)
2", johnson 6 dot
(size) (material)
- (6) pump 1, 3
(HP) (yield gpm)
elec
(type power)
- (7) electric log ---
(yes or no)
(organization running log)
- (8) how well bottom plugged ball

description of formations encountered

from to

<u>mud & sand</u>	<u>0</u>	<u>20</u>
<u>sand</u>	<u>30</u>	<u>40</u>
<u>mud</u>	<u>40</u>	<u>120</u>
<u>mud & sand</u>	<u>120</u>	<u>140</u>
<u>mud</u>	<u>140</u>	<u>180</u>
<u>mud & sand</u>	<u>180</u>	<u>200</u>
<u>sand</u>	<u>200</u>	<u>215</u>


DRILLERS REMARKS:

DEPT. OF NATURAL RESOURCES
BUREAU OF LAND & WATER RESOURCES

AUG 16 1984
RECEIVED

If well telescopes please
sketch and show depths.

GROUND LEVEL

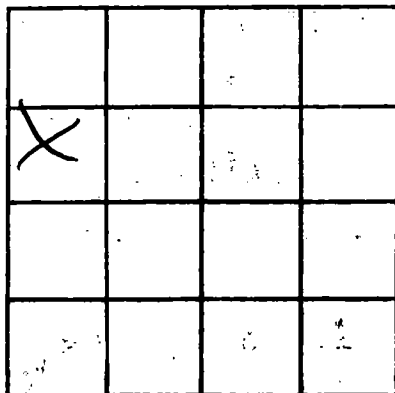

X			

SECTION _____

Please indicate well location X.

ADDITIONAL INFORMATION

If more than one screen,
show locations of each on sketch.