

MISSISSIPPI DEPARTMENT OF NATURAL RESOURCES

Bureau of Land and Water Resources

Southport Mall

P.O. Box 10631

Jackson, Mississippi 39209

WATER WELL DRILLERS LOG

Harrison  
N  
2079

Harrison Well

Harrison

9/14/84 19  
date well completed

firm name

county well located


LANDOWNER	description of formations encountered	from	to
JAB Const. 204 Briar Lane	white sand	0	60
Pass Christian 39571 (mailing address)	blue clay	60	149
WELL LOCATION: sec. <u>23</u> T. <u>8</u> N. R. <u>13</u> E. <u>2</u> miles <u>W</u> of <u>Pass Christian</u> (distance) (direction) (nearest town)	Sand	148	172
WELL PURPOSE: <u>Home</u> (home, irrigation, municipal, industrial)			
WELL COMPLETION DATA:			
(1) diameter (inches) <u>4x2</u>			
(2) total depth (feet) <u>172'</u>			
(3) static water level (feet) <u>3'</u> <sup>below</sup> above top of ground.			
(4) casing <u>PVC</u> , <u>152'</u> (material) (depth) <u>4x2</u> (size) If telescope see back.			
(5) screen <u>20'</u> , <u>152'</u> (length) (depth to top) <u>2"</u> , <u>PVC</u> (size) (material)			
(6) pump <u>1</u> , <u>25</u> (HP) (yield gpm) <u>electric</u> (type power)			
(7) electric log <u>NO</u> (yes or no) <u>No</u> (organization running log)			
(8) how well bottom plugged <u>Sand Shark</u>			
DRILLERS REMARKS:			

DEPT. OF NATURAL RESOURCES  
BUREAU OF LAND & WATER RESOURCES

DEC 10 1984

RECEIVED

If well telescopes please sketch and show depths.

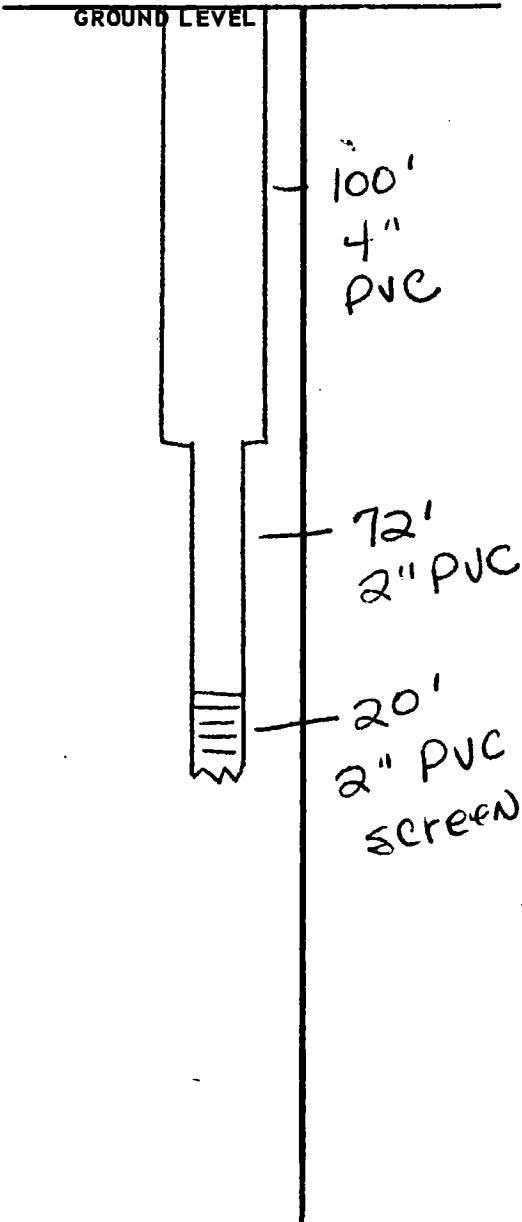

	X		

SECTION 23

Please indicate well location X.

ADDITIONAL INFORMATION

Series of horizontal lines for additional information, with some faint markings and numbers like (2), (3), (4), (5), (6), (7), (8) visible.

If more than one screen, show locations of each on sketch.