

MISSISSIPPI DEPARTMENT OF NATURAL RESOURCES

Bureau of Land and Water Resources

Southport Mall

P.O. Box 10631

Jackson, Mississippi 39209

WATER WELL DRILLERS LOG

HARRISON  
N 2081

5/16/85 19  
date well completed

Lyman Well Co  
firm name

Harrison  
county well located

LANDOWNER: Jean Lavage  
1508 Pasadena Ave.  
Metairie, La 70001  
(mailing address)

description of formations encountered	from	to
TOP SAND	0	40
WHITE CLAY	40	80
GRAY CLAY	80	150
SAND CORSE	150	170

WELL LOCATION:  
sec. 34 T. 8 N. R. 13 E  
5 miles SOUTH of BASTROP  
(distance) (direction) (nearest town)

WELL PURPOSE:  
(home, irrigation, municipal, industrial)

- WELL COMPLETION DATA:
- (1) diameter (inches) 2"
  - (2) total depth (feet) 170'
  - (3) static water level (feet) 10' <sup>below</sup> above top of ground.
  - (4) casing PVC 160'  
(material) (depth)
  - 2" If telescope see back.  
(size)
  - (5) screen 10' 160'  
(length) (depth to top)
  - 2" PVC  
(size) (material)
  - (6) pump 1/2 12  
(HP) (yield gpm)
  - electric  
(type power)
  - (7) electric log No  
(yes or no)
  - No  
(organization running log)
  - (8) how well bottom plugged sand  
shark


RECEIVED  
AUG 20 1985

DRILLERS REMARKS:

Department of Natural Resources  
Bureau of Land & Water Resources

If well telescopes please sketch and show depths.

GROUND LEVEL

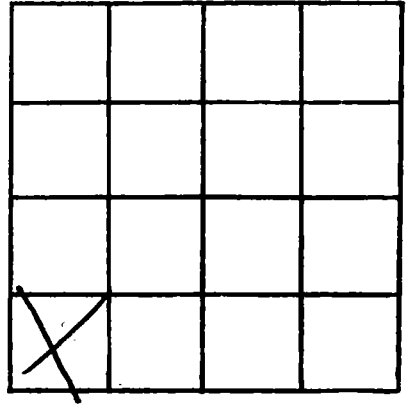

SECTION 34

Please indicate well location X.

ADDITIONAL INFORMATION

If more than one screen, show locations of each on sketch.