

MISSISSIPPI DEPARTMENT OF NATURAL RESOURCES

Bureau of Land and Water Resources

Southport Mall

P.O. Box 10631

Jackson, Mississippi 39209

WATER WELL DRILLERS LOG

Harrison
N
2083

6/25/85 19 Lyman Well Co. Harrison
 date well completed firm name county well located

LANDOWNER: Mike Matheny
19 Pine Dr.
Pass Christian, MS 39571
 (mailing address)

description of formations encountered	from	to
<u>white clay</u>	<u>0</u>	<u>40</u>
<u>gray clay</u>	<u>40</u>	<u>100</u>
<u>fine sand</u>	<u>100</u>	<u>120</u>
<u>gray clay</u>	<u>120</u>	<u>650</u>
<u>5' sand core</u>	<u>650</u>	<u>660</u>

WELL LOCATION:
 sec. 19 T. 8 N. R. 23 E.
 S. W.
5 miles north of Princeton
 (distance) (direction) (nearest town)

WELL PURPOSE: home
 (home, irrigation, municipal, industrial)

- WELL COMPLETION DATA:
- (1) diameter (inches) 2"
 - (2) total depth (feet) 660'
 - (3) static water level (feet) 2' below top of ground.
 - (4) casing PVC, 650'
 (material) (depth)
2"
 (size) If telescope see back.
 - (5) screen 10', 650'
 (length) (depth to top)
2", PVC
 (size) (material)
 - (6) pump 1, 15
 (HP) (yield gpm)
electric
 (type power)
 - (7) electric log No
 (yes or no)
No
 (organization running log)
 - (8) how well bottom plugged sand
shark


RECEIVED
 APR 9 1986

DRILLERS REMARKS:

Department of Natural Resources
 Bureau of Land & Water Resources

If well telescopes please sketch and show depths.

GROUND LEVEL

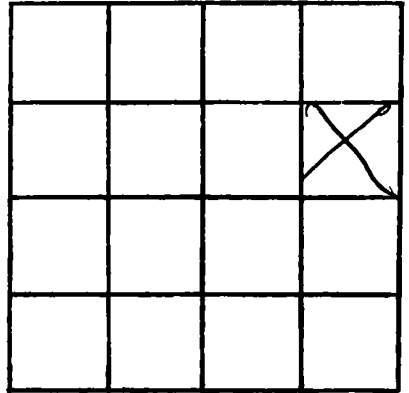

SECTION 19

Please indicate well location X.

ADDITIONAL INFORMATION

If more than one screen, show locations of each on sketch.