

MISSISSIPPI DEPARTMENT OF NATURAL RESOURCES
 Bureau of Land and Water Resources
 Southport Mall
 P.O. Box 10631
 Jackson, Mississippi 39209
WATER WELL DRILLERS LOG

N 2086
 Harrison
 9-26-85

9-26 1985 date well completed McMill Pump & Well firm name Harrison county well located

LANDOWNER: RC. Keel
Rt. 3 Box 106
Pass Christian Ms. 39571
 (mailing address)

WELL LOCATION:
 sec 16 T 8 N R 13 E
3/4 miles S of Delisle
 (distance) (direction) (nearest town)

WELL PURPOSE:
 (home, irrigation, municipal, industrial)

WELL COMPLETION DATA: 120'-4"
426'-2"

- (1) diameter (inches) 4" x 2"
- (2) total depth (feet) 540'
- (3) static water level (feet) 1 below above top of ground.
- (4) casing Sch 40 PVC 530'
 (material) (depth)
 (size) if telescope see back.
- (5) screen 20' 530'
 (length) (depth to top)
2" Sch 80 PVC - 6 slot
 (size) (material)
- (6) pump 1 20
 (HP) (yield gpm)
Elec
 (type power)
- (7) electric log _____
 (yes or no)

 (organization running log)

(8) how well bottom plugged SAND
SHARK

DRILLERS REMARKS:

description of formations encountered	from	to
<u>Sand / Gravel</u>	<u>0</u>	<u>40</u>
<u>Sand / Mud</u>	<u>40</u>	<u>80</u>
<u>Mud</u>	<u>80</u>	<u>200</u>
<u>Mud / Sand</u>	<u>200</u>	<u>220</u>
<u>Mud</u>	<u>220</u>	<u>480</u>
<u>Sand</u>	<u>480</u>	<u>540</u>


RECEIVED

OCT 28 1985

Department of Natural Resources
 Bureau of Land & Water Resources

If well telescopes please sketch and show depths.

GROUND LEVEL

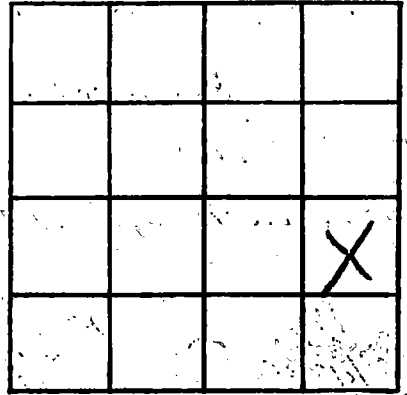

SECTION _____

Please indicate well location X.

ADDITIONAL INFORMATION

If more than one screen, show locations of each on sketch.