

MISSISSIPPI DEPARTMENT OF NATURAL RESOURCES

Bureau of Land and Water Resources

Southport Mall

P.O. Box 10631

Jackson, Mississippi 39209

WATER WELL DRILLERS LOG

Harrison  
N 2087

date well completed 3/16/86 firm name Lyman Well Co county well located Harrison

LANDOWNER Bill Kamminga

1st Street

Pass Christian 395  
(mailing address)

WELL LOCATION:

sec 27 T 8 N R 13 E  
4 miles West of Pass Christian  
(distance) (direction) (nearest town)

WELL PURPOSE: Home  
(home, irrigation, municipal, industrial)

WELL COMPLETION DATA:

- (1) diameter (inches) 2"
- (2) total depth (feet) 344'
- (3) static water level (feet) 7'  below  above top of ground.
- (4) casing PVC, 334'  
(material) (depth)  
2" If telescope see back.  
(size)
- (5) screen 10', 334'  
(length) (depth to top)  
2", PVC  
(size) (material)
- (6) pump N/A  
(HP) (yield gpm)  
(type power)
- (7) electric log No  
(yes or no)  
No  
(organization running log)
- (8) how well bottom plugged sand  
shark

DRILLERS REMARKS: None

Description of formations encountered

from

to

Sandy Top Soil	0	1'
Kelbitt sand	1'	23'
White sandy clay	23'	65'
Fine salt & pepper sand	65'	108'
Blue clay	108'	152'
Salt & pepper sand	152'	160'
Blue clay	160'	204'
Fine salt & pepper sand	204'	236'
Blue clay	236'	287'
Salt & pepper sand	287'	293'
Blue clay	293'	315'
Course Salt & Pepper sand	315'	334'


**RECEIVED**

OCT 06 1986

Department of Natural Resources  
Bureau of Land & Water Resources

If well telescopes please sketch and show depths.

GROUND LEVEL

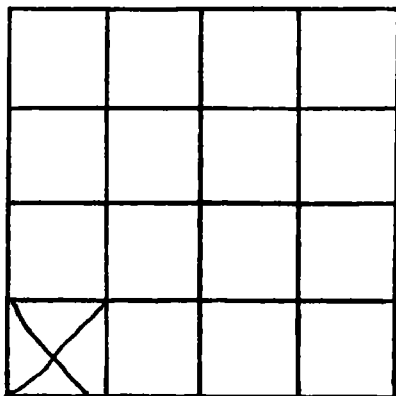

SECTION 27

Please indicate well location X.

ADDITIONAL INFORMATION

If more than one screen,  
show locations of each on sketch.