

MISSISSIPPI DEPARTMENT OF NATURAL RESOURCES

Bureau of Land and Water Resources

Southport Mall

P.O. Box 10631

Jackson, Mississippi 39209

WATER WELL DRILLERS LOG

HARRISON
N
2089

March 7 19 86 Ward Well Drg. Harrison
 date well completed firm name county well located

LANDOWNER	description of formations encountered	from	to
Bill M ^r Down Inc.			
Front St. - Henderson St.	Fill - Sandy clay	0	54
Pass Christian Mrs.	Clay - Silt	54	68
(mailing address)	Med. Coar. sd	68	285
		285	332

WELL LOCATION:
 sec 29 T 8 N R 13 E
 3 miles S/W of Pass Christian
 (distance) (direction) (nearest town)

WELL PURPOSE: None
 (home, irrigation, municipal, industrial)


- WELL COMPLETION DATA:
- (1) diameter (inches) 2"
 - (2) total depth (feet) 332
 - (3) static water level (feet) 12 below above top of ground.
 - (4) casing PVC 322 (material) (depth)
 - (size) if telescope see back.
 - (5) screen 10' (length) (depth to top)
 - 2" PVC (size) (material)
 - (6) pump none (HP) (yield gpm)
 - (type power)
 - (7) electric log nd (yes or no)
 - U/A (organization running log)
 - (8) how well bottom plugged BWV

RECEIVED
 APR 11 1986

DRILLERS REMARKS: [Signature]

If well telescopes please sketch and show depths.

GROUND LEVEL

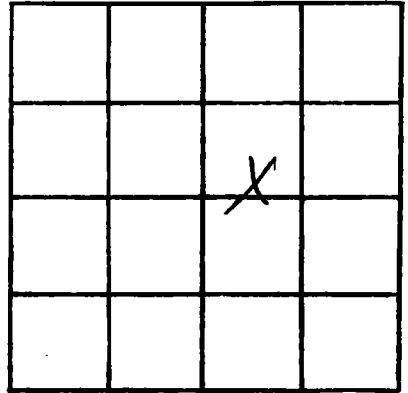

SECTION 27

Please indicate well location X.

ADDITIONAL INFORMATION

From the 68 ft. depth we had to see clay with silt and no more than 1 ft. streaks of fine ss. till approx. 285.

If more than one screen, show locations of each on sketch.