

MISSISSIPPI DEPARTMENT OF NATURAL RESOURCES

Bureau of Land and Water Resources

Southport Mall

P.O. Box 10631

Jackson, Mississippi 39209

WATER WELL DRILLERS LOG

HARRISON  
N 2092

2 date well completed McMill Pump Well firm name Harrison county well located

LANDOWNER: Mark Oakley  
Rt. 3, Box 154  
Pass Christian Ms.  
 (mailing address)

description of formations encountered	from	to
<u>Sand - gravel</u>	<u>0</u>	<u>80</u>
<u>mud</u>	<u>80</u>	<u>400</u>
<u>Sand</u>	<u>400</u>	<u>415</u>
<u>mud</u>	<u>415</u>	<u>480</u>
<u>Sand</u>	<u>480</u>	<u>530</u>

WELL LOCATION:  
 sec. 3 T. 8 N. R. 13 E.  
 (S) (W)  
 \_\_\_\_\_ miles \_\_\_\_\_ of \_\_\_\_\_  
 (distance) (direction) (nearest town)

WELL PURPOSE: home  
 (home, irrigation, municipal, industrial)

- WELL COMPLETION DATA:
- (1) diameter (inches) 4" x 2"
  - (2) total depth (feet) 530'
  - (3) static water level (feet) 5' <sup>below</sup> <sub>above</sub> top of ground.
  - (4) casing PVC 510'  
 (material) (depth)  
4x2 if telescope see back.  
 (size)
  - (5) screen 20' Bottom  
 (length) (depth to top)  
2" PVC  
 (size) (material)
  - (6) pump 1 1/2 25  
 (HP) (yield gpm)  
electric  
 (type power)
  - (7) electric log no  
 (yes or no)  
 \_\_\_\_\_  
 (organization running log)
  - (8) how well bottom plugged Seal

**RECORDED**  
 AUG 19 1980

Department of Natural Resources  
 Bureau of Land and Water Resources

DRILLERS REMARKS:

If well telescopes please sketch and show depths.


GROUND LEVEL

120'

410'

4" Top

2" Bottom

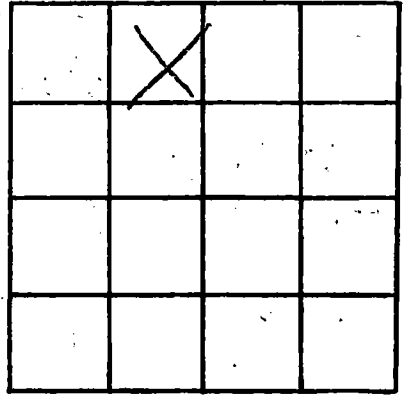

SECTION \_\_\_\_\_

Please indicate well location X.

ADDITIONAL INFORMATION

If more than one screen, show locations of each on sketch.