

MISSISSIPPI DEPARTMENT OF NATURAL RESOURCES

Bureau of Land and Water Resources

Southport Mall

P.O. Box 10631

Jackson, Mississippi 39209

WATER WELL DRILLERS LOG

Harrison
N
2093

6-14-86 19 McMill Pump & Well Harrison
date well completed firm name county well located

LANDOWNER: Mrs Grant
Montebello
Ross Christian M
(mailing address)

description of formations encountered	from	to
Mud	0	10
Sand	10	40
mud	40	260
Sand	260	280
mud	280	360
Sand	360	400
Mud	400	560
Sand & Gravel	560	600

WELL LOCATION:
sec. 18T 8 N R. 13 E
2 miles South of Pinville
(distance) (direction) (nearest town)

WELL PURPOSE: home
(home, irrigation, municipal, industrial)

WELL COMPLETION DATA:

(1) diameter (inches) 2"

(2) total depth (feet) 600'

(3) static water level (feet) 7 ^{below} 500' above top of ground

(4) casing PVC 350'
(material) (depth)

2"
(size) if telescope see back.

(5) screen 10' Bottom
(length) (depth to top)

2" PVC
(size) (material)

(6) pump OWN
(HP) (yield gpm)

Electric
(type power)

(7) electric log NO
(yes or no)

(organization running log)

(8) how well bottom plugged Seal


RECORDED
AUG 7 1986

Department of Natural Resources
Bureau of Land & Water Resources

DRILLERS REMARKS:

If well telescopes please sketch and show depths.

GROUND LEVEL

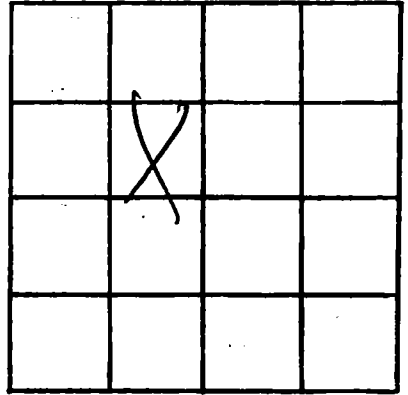

SECTION _____

Please indicate well location X.

ADDITIONAL INFORMATION

If more than one screen, show locations of each on sketch.