

MISSISSIPPI DEPARTMENT OF NATURAL RESOURCES
Bureau of Land and Water Resources
 Southport Mall
 P.O. Box 10631
 Jackson, Mississippi 39209
WATER WELL DRILLERS LOG

HARRISON
N 2094

July 15 1986 McNeil Pump & Well Harrison
 date well completed firm name county well located

LANDOWNER: Sam Deke
622 Saraya Dr.
Hulfport Ms.
 (mailing address)

description of formations encountered	from	to
	<u>SAND</u>	<u>0</u>

WELL LOCATION:
 sec. 15 T. 7 N. R. 11 E.
2 miles East of Hulfport
 (distance) (direction) (nearest town)

WELL PURPOSE: irrigation
 (home, irrigation, municipal, industrial)

- WELL COMPLETION DATA:
- (1) diameter (inches) 2"
 - (2) total depth (feet) 30'
 - (3) static water level (feet) 2' ^{below} _{above} top of ground
 - (4) casing PVC, 20'
 (material) (depth)
2" if telescope see back.
 (size)
 - (5) screen 10', Bottom
 (length) (depth to top)
2", PVC
 (size) (material)
 - (6) pump 1/2, 5
 (HP) (yield gpm)
Electric
 (type power)
 - (7) electric log NO
 (yes or no)
- (organization running log)
- (8) how well bottom plugged Seal


DRILLERS REMARKS:

RECEIVED
 AUG 26 1986

Department of Natural Resources
 Bureau of Land & Water Resources

If well telescopes please sketch and show depths.

GROUND LEVEL

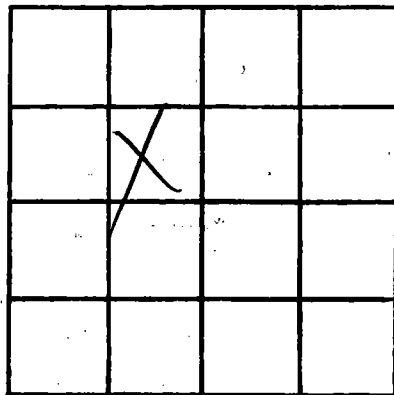

SECTION _____

Please indicate well location X.

ADDITIONAL INFORMATION

If more than one screen, show locations of each on sketch.