

MISSISSIPPI DEPARTMENT OF NATURAL RESOURCES

Bureau of Land and Water Resources

Southport Mall

P.O. Box 10631

Jackson, Mississippi 39209

WATER WELL DRILLERS LOG

HARRISON
N 2095

Sept. 23 1986 Wood Well Dlg Harrison
date well completed firm name county well located

LANDOWNER: U.S. Keel, Mr. Co.
Aracadio Rd.
Joss Christian, Mrs.
(mailing address)


WELL LOCATION:
sec. 12 T 8 N R 13 E
8 miles W of Knatchville
(distance) (direction) (nearest town)

WELL PURPOSE: Home
(home, irrigation, municipal, industrial)

WELL COMPLETION DATA:

- (1) diameter (inches) 2"
- (2) total depth (feet) 505
- (3) static water level (feet) 2 below above top of ground.
- (4) casing PVC 485
(material) (depth)
(size) If telescope see back.
- (5) screen 20' -
(length) (depth to top)
2" PVC
(size) (material)
- (6) pump owner -
(HP) (yield gpm)
(type power)
- (7) electric log NO
(yes or no)
N/A
(organization running log)
- (8) how well bottom plugged BWD

description of formations encountered	from	to
<u>fill-clay</u>	<u>0</u>	<u>10</u>
<u>clay-silt</u>	<u>10</u>	<u>38</u>
<u>clay-silt</u>	<u>38</u>	<u>120</u>
<u>clay-silt</u>	<u>120</u>	<u>145</u>
<u>clay-silt</u>	<u>145</u>	<u>240</u>
<u>clay-silt</u>	<u>240</u>	<u>258</u>
<u>Case sd</u>	<u>258</u>	<u>455</u>
	<u>455</u>	<u>505</u>

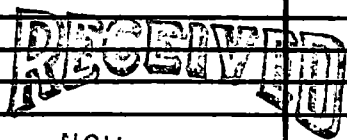

NOV 14 1986

Department of Natural Resources
Bureau of Land & Water Resources

DRILLERS REMARKS: N/A

If well telescopes please sketch and show depths.

GROUND LEVEL

			X

SECTION 12

Please indicate well location X.

ADDITIONAL INFORMATION

If more than one screen, show locations of each on sketch.