

MISSISSIPPI DEPARTMENT OF NATURAL RESOURCES

Bureau of Land and Water Resources

Southport Mall

P.O. Box 10631

Jackson, Mississippi 39209

WATER WELL DRILLERS LOG

HARRISON
N 2098

7-15-87 19
date well completed

R. J. McNehe
firm name

HARRISON
county well located

LANDOWNER:
KEVIN GALLAGHER
HENDERSON Ave

Dellisle, MS
(mailing address)

WELL LOCATION:
sec. *16* T. *8* N. R. *13* E. *(W)*
1/4 miles *IN* *Dellisle* of (nearest town)

WELL PURPOSE:
(Home, irrigation, municipal, industrial)

WELL COMPLETION DATA:

- (1) diameter (inches) *2"*
- (2) total depth (feet) *550*
- (3) static water level (feet) *2'* *below* *above* top of ground.
- (4) casing *PVC*, *550'*,
(material) (depth)
- (size) If telescope see back.
- (5) screen *10'*, *550'*
(length) (depth to top)
- 2"*, *PVC*
(size) (material)
- (6) pump *1*, *12*
(HP) (yield gpm)
- F*
(type power)
- (7) electric log *—*
(yes or no)

(organization running log)

(8) how well bottom plugged
Proper

DRILLERS REMARKS:

description of formations encountered	from	to
<i>TOP SOIL</i>	<i>0</i>	<i>20</i>
<i>Red Silty & Gravel</i>	<i>20</i>	<i>60</i>
<i>Blue Clay</i>	<i>60</i>	<i>500</i>
<i>Orange Silty & Gravel</i>	<i>500</i>	<i>550</i>


RECEIVED

NOV 04 1987

Department of Natural Resources
Bureau of Land & Water Resources

If well telescopes please
sketch and show depths.

GROUND LEVEL

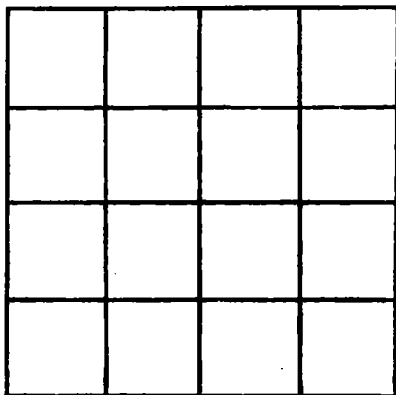

2 Bldgs South
Dellisle School
SECTION _____
ON DELLISLE ROAD
Please indicate well location X.

ADDITIONAL INFORMATION

If more than one screen,
show locations of each on sketch.