

MISSISSIPPI DEPARTMENT OF NATURAL RESOURCES

Bureau of Land and Water Resources

Southport Mall

P.O. Box 10631

Jackson, Mississippi 39209

WATER WELL DRILLERS LOG

Harrison  
N 2102

4-23-88 19  
date well completed

R.V. Moore  
firm name

HARRISON  
county well located

LANDOWNER: Melvin Moore

Melvin Moore North

PASS CHRISTIAN MS  
(mailing address)

WELL LOCATION:

sec. 6 T 8 N R 13 E

(distance) miles (direction) of (nearest town)

WELL PURPOSE:

(home, irrigation, municipal, industrial)

WELL COMPLETION DATA:

(1) diameter (inches) 2"

(2) total depth (feet) 400'

(3) static water level (feet) 4' below  
top of ground. above

(4) casing PVC, 400'  
(material) (depth)

(size) If telescope see back.

(5) screen 10', 400'  
(length) (depth to top)

2", PVC  
(size) (material)

(6) pump 3/4, 22  
(HP) (yield gpm)

E  
(type power)

(7) electric log (yes or no)

(organization running log)

(8) how well bottom plugged  
B.W. Moore

description of formations encountered

from

to

TOP SOIL	0	10
Reddish Sand & Gravel	10	40
White & Blue Clay	40	160
Sandy Sand	160	190
Blue Clay	190	360
Med Sand	360	380
Coarse Sand	380	400

RECEIVED


MAY 09 1988

Department of Natural Resources  
Bureau of Land & Water Resources

DRILLERS REMARKS:

If well telescopes please sketch and show depths.

GROUND LEVEL

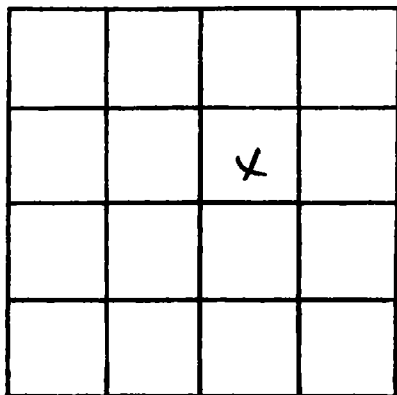

SECTION 6

Please indicate well location X.

ADDITIONAL INFORMATION

If more than one screen,  
show locations of each on sketch.