

MISSISSIPPI DEPARTMENT OF NATURAL RESOURCES
Bureau of Land and Water Resources

P.O. Box 10631

Jackson, Mississippi 39209

WATER WELL DRILLERS LOG

| | |
|--|-------|
| COUNTY WELL LOCATED <u>Harrison</u> | |
| WELL NUMBER <u>N 2107</u> | CODED |
| DATE WELL COMPLETED <u>3-6-89</u> | |

| |
|--|
| PERMIT NUMBER <u>0-193</u> |
| NAME OF DRILLING FIRM <u>Bobby Beal's Well Works Inc.</u> |

| | | | |
|--|------------------|------------------------|----------------------|
| NAME & MAILING ADDRESS OF LANDOWNER <u>Neverson Point</u> <u>102 West 1st Street</u> <u>Pass Christian Ms.</u> | | | |
| WELL LOCATION: | SEC <u>33</u> | TOWNSHIP <u>8 N</u> | RANGE <u>13 E</u> |
| DISTANCE | DIRECTION | NEAREST TOWN | |
| _____ Miles | _____ of _____ | | |
| OTHER LANDMARK | | | |
| WELL PURPOSE: <input checked="" type="radio"/> Home Irrigation, <input type="radio"/> Municipal, <input type="radio"/> Industrial, <input type="radio"/> Fish Pond, etc. | | | |

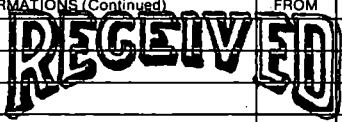
| | | |
|---|---------------|--------------------------------|
| PUMP DATA | | |
| PUMP TYPE (Circle One): <input checked="" type="radio"/> Submersible, <input type="radio"/> Turbine, <input type="radio"/> Jet, <input type="radio"/> Flowing Well, Other (Describe) <u>1.5</u> | | |
| POWER TYPE (Circle One): <input checked="" type="radio"/> Electric, <input type="radio"/> Tractor, <input type="radio"/> Diesel, <input type="radio"/> Gasoline, <input type="radio"/> Butane, Other (Describe) _____ | | |
| Pump Capacity (GPM) | No. of Stages | Setting Depth <u>23</u> FT. |
| PUMP TEST | | |
| Well yielded _____ GPM with a drawdown of _____ ft. after _____ hours of pumping | | |

| | | |
|---|--|---|
| WELL DATA | | |
| Well Depth <u>200</u> | Casing Diameter (In.) <u>4"</u> | Casing Length (Ft.) <u>20 ft.</u> |
| Type of Casing <u>PVC</u> | Hole Depth <u>2"</u> | Depth to Static Water Level <u>3 ft.</u> |
| TYPE OF COMPLETION: (Circle One or More): <input checked="" type="radio"/> Gravel Packed, <input type="radio"/> Underreamed, <input type="radio"/> Telescoped, <input checked="" type="radio"/> Natural Development, <input type="radio"/> Open Hole, <input type="radio"/> Other | | |
| Top of Lap Pipe or Reduction in Casing | | |
| FEET | IF TELESCOPED OR MORE THAN ONE SCREEN: USE BACK PAGE | |

| | |
|--|--|
| LOG DATA | |
| TYPE OF LOG RUN (Circle One): <input type="radio"/> No Log Run, <input type="radio"/> Electric, <input type="radio"/> Gamma Ray, <input type="radio"/> Density, <input type="radio"/> Sonic, <input type="radio"/> Neutron, Other (Describe) _____ | |
| Name of Organization Running Log <u>Bobby Beal Well Works</u> | |

| | | |
|--------------------------------------|--------------------------------------|-----------------------------------|
| SCREEN DATA | | |
| Diameter - Inches <u>2"</u> | Length - Feet <u>20 ft.</u> | Slot Size - Inches <u>#180</u> |
| Screen Type <u>Johnson Screen</u> | Depth to Bottom - Feet <u>200</u> | |

| | | | |
|---------------------------------|---------------|----------------|--------------|
| GEOLOGIC DATA (Office Use Only) | | | |
| Surface Elev. | Geologic Unit | Unit Thickness | Depth to Top |
| Subs. SWL | Date | Analysis | Aquifer Test |
| Driller's Remarks | | | |

| DESCRIPTION OF FORMATIONS ENCOUNTERED | FROM | TO | FORMATIONS (Continued) | FROM | TO |
|---|------|----|------------------------|------|----|
|  MAY 15 1990 Department of Natural Resources Bureau of Land & Water Resources | | | | | |
| IF MORE SPACE IS NEEDED, USE BACK | | | | | |

If well telescopes please sketch and show depths.

GROUND LEVEL

| | | | |
|--|--|--|--|
| | | | |
| | | | |
| | | | |
| | | | |

SECTION _____

Please indicate well location X.

ADDITIONAL INFORMATION

RECEIVED
DEPT. OF AGRICULTURE
WASHINGTON, D.C.

U.S. GOVERNMENT PRINTING OFFICE

1964 O - 348-001

If more than one screen, show location of each on sketch.