

MISSISSIPPI DEPARTMENT OF NATURAL RESOURCES

Bureau of Land and Water Resources

P.O. Box 10631
Jackson, Mississippi 39209
WATER WELL DRILLERS LOG

COUNTY WELL LOCATED N Harrison	
WELL NUMBER N 2112	CODED
DATE WELL COMPLETED Sept 25-89	

PERMIT NUMBER 0239
NAME OF DRILLING FIRM McMill Pump & Wells

NAME & MAILING ADDRESS OF LANDOWNER Wade Miles Lindsay Ave Pass Christian MS	
WELL LOCATION: SEC TOWNSHIP RANGE 6 8 N 13 E	
DISTANCE DIRECTION NEAREST TOWN 2 Miles East of Pineville	
OTHER LANDMARK	
WELL PURPOSE: <input checked="" type="checkbox"/> Irrigation, <input type="checkbox"/> Municipal, <input type="checkbox"/> Industrial, <input type="checkbox"/> Fish Pond, etc.	

PUMP DATA		
PUMP TYPE (Circle One): Submersible, Turbine, <input checked="" type="radio"/> Jet, Flowing Well, Other (Describe) _____		
POWER TYPE (Circle One): <input checked="" type="radio"/> Electric, <input type="radio"/> Tractor, <input type="radio"/> Diesel, <input type="radio"/> Gasoline, <input type="radio"/> Butane, Other (Describe) _____ H/P _____		
Pump Capacity (GPM) 12	No. of Stages 2	Setting Depth 50' FT.
PUMP TEST Well yielded 12 GPM with a drawdown of 10 ft. after 1 hours of pumping		

WELL DATA		
Well Depth 150	Casing Diameter (In.) 2"	Casing Length (Ft.) 20'
Type of Casing PVC	Hole Depth 150	Depth to Static Water Level 25'
TYPE OF COMPLETION: (Circle One or More): <input checked="" type="checkbox"/> Gravel Packed, <input type="checkbox"/> Underreamed, <input type="checkbox"/> Telescoped, <input checked="" type="checkbox"/> Natural Development, <input type="checkbox"/> Open Hole, <input type="checkbox"/> Other (Describe) _____		
Top of Lap Pipe or Reduction in Casing FEET IF TELESCOPED OR MORE THAN ONE SCREEN: USE BACK PAGE		

LOG DATA	
TYPE OF LOG RUN (Circle One): Electric, Gamma Ray, Density, Sonic, <input checked="" type="radio"/> No. Log Run, Neutron, Other (Describe) _____	
Name of Organization Running Log	

SCREEN DATA		
Diameter - Inches 2"	Length - Feet 10'	Slot Size - Inches .0006
Screen Type PVC	Depth to Bottom - Feet 150'	


GEOLOGIC DATA (Office Use Only)			
Surface Elev.	Geologic Unit	Unit Thickness	Depth to Top
Subs. SWL	Date	Analysis	Aquifer Test

Driller's Remarks

DESCRIPTION OF FORMATIONS ENCOUNTERED	FROM	TO	FORMATIONS (Continued)	FROM	TO
			RECEIVED		
mud	0	10			
sand	10	40			
mud	40	130			
sand	130	150			
			AUG 16 1990		
			Department of Natural Resources Bureau of Land & Water Resources		
IF MORE SPACE IS NEEDED, USE BACK					

If well telescopes please sketch and show depths.

GROUND LEVEL

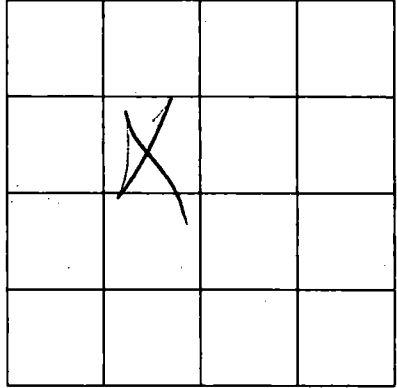

SECTION _____

Please indicate well location X.

ADDITIONAL INFORMATION

If more than one screen,
show location of each on sketch.