

MISSISSIPPI DEPARTMENT OF NATURAL RESOURCES

Bureau of Land and Water Resources

P.O. Box 10631
Jackson, Mississippi 39209
WATER WELL DRILLERS LOG

| | |
|--|-------|
| COUNTY WELL LOCATED N Harrison | |
| WELL NUMBER N 2113 | CODED |
| DATE WELL COMPLETED Oct 27, 1989 | |

| |
|--|
| PERMIT NUMBER 0239 |
| NAME OF DRILLING FIRM Merid Pump & Wells |

| | | |
|---|-------------|-----------------------|
| NAME & MAILING ADDRESS OF LANDOWNER 2nd Street Pass Christian ms. | | |
| WELL LOCATION: SEC | TOWNSHIP | RANGE |
| 25 | 8 | N 13 E |
| DISTANCE | DIRECTION | NEAREST TOWN |
| 2 Miles | West | Pass Christian |
| OTHER LANDMARK | | |
| WELL PURPOSE: <input checked="" type="radio"/> Home, <input type="radio"/> Irrigation, <input type="radio"/> Municipal, <input type="radio"/> Industrial, <input type="radio"/> Fish Pond, etc. | | |

| | | |
|---|----------------------------|---------------------------------|
| PUMP DATA | | |
| PUMP TYPE (Circle One): <input checked="" type="radio"/> Submersible, <input type="radio"/> Turbine, <input type="radio"/> Jet <input type="radio"/> Flowing Well, Other (Describe) _____ | | |
| POWER TYPE (Circle One): <input checked="" type="radio"/> Electric, <input type="radio"/> Tractor, <input type="radio"/> Diesel, <input type="radio"/> Gasoline, <input type="radio"/> Butane, Other (Describe) _____ H/P _____ | | |
| Pump Capacity (GPM) 18 | No. of Stages 14 | Setting Depth 60' FT. |
| PUMP TEST | | |
| Well yielded 18 GPM with a drawdown of 15 ft. after 1 hours of pumping | | |

| | | |
|---|---|---|
| WELL DATA | | |
| Well Depth 680' | Casing Diameter (In.) 4" X 3" | Casing Length (Ft.) 20' |
| Type of Casing PVC | Hole Depth 680' | Depth to Static Water Level 30' |
| TYPE OF COMPLETION: (Circle One or More): <input checked="" type="radio"/> Gravel Packed, <input type="radio"/> Underreamed, <input type="radio"/> Telescoped, <input checked="" type="radio"/> Natural Development, <input type="radio"/> Open Hole, <input type="radio"/> Other (Describe) _____ | | |
| Top of Lap Pipe or Reduction in Casing FEET IF TELESCOPED OR MORE THAN ONE SCREEN: USE BACK PAGE | | |

| | |
|---|--|
| LOG DATA | |
| TYPE OF LOG RUN (Circle One): <input checked="" type="radio"/> Electric, <input type="radio"/> Gamma Ray, <input type="radio"/> Density, <input type="radio"/> Sonic, <input type="radio"/> Neutron, Other (Describe) _____ No Log Run | |
| Name of Organization Running Log | |

| | | |
|--------------------------------|---------------------------------------|------------------------------------|
| SCREEN DATA | | |
| Diameter - Inches 2" | Length - Feet 20' | Slot Size - Inches .0026 |
| Screen Type PVC | Depth to Bottom - Feet 650' | |

| GEOLOGIC DATA (Office Use Only) | | | |
|---------------------------------|---------------|----------------|--------------|
| Surface Elev. | Geologic Unit | Unit Thickness | Depth to Top |
| Subs. SWL | Date | Analysis | Aquifer Test |

| |
|-------------------|
| Driller's Remarks |
| |
| |


| DESCRIPTION OF FORMATIONS ENCOUNTERED | FROM | TO |
|---------------------------------------|------------|------------|
| 9 mud | 0 | 40 |
| Sand | 40 | 160 |
| mud | 160 | 208 |
| Sand | 200 | 220 |
| mud | 220 | 440 |
| Sand | 440 | 480 |
| mud | 480 | 630 |
| Sand | 630 | 680 |

| FORMATIONS (Continued) | FROM | TO |
|---|------|----|
| RECEIVED | | |
| AUG 16 1990 | | |
| Department of Natural Resources | | |
| Bureau of Land & Water Resources | | |
| | | |
| | | |

IF MORE SPACE IS NEEDED, USE BACK

If well telescopes please sketch and show depths.

GROUND LEVEL

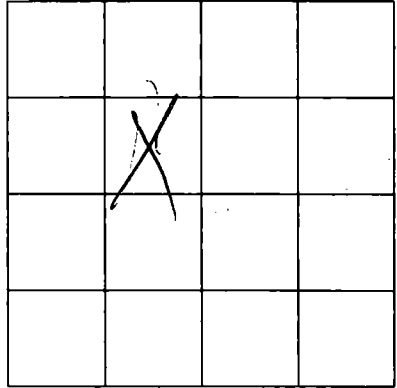

SECTION _____

Please indicate well location X.

ADDITIONAL INFORMATION

200'-4" PVC
450'-2" PVC

If more than one screen,
show location of each on sketch.