

MISSISSIPPI DEPARTMENT OF NATURAL RESOURCES

Bureau of Land and Water Resources

P.O. Box 10631
Jackson, Mississippi 39209
WATER WELL DRILLERS LOG

COUNTY WELL LOCATED Harrison	
WELL NUMBER N 2114	CODED
DATE WELL COMPLETED Oct. 25 - 1989	

PERMIT NUMBER 0239
NAME OF DRILLING FIRM McMill Pump & Wells

NAME & MAILING ADDRESS OF LANDOWNER Basil Martin East Hudson Rd. Poss Christian ms.			
WELL LOCATION:	SEC 35	TOWNSHIP 8	RANGE N 13 E
DISTANCE 2 Miles	DIRECTION West	NEAREST TOWN of Poss Christian	
OTHER LANDMARK			
WELL PURPOSE <input checked="" type="checkbox"/> Home Irrigation, Municipal, Industrial, Fish Pond, etc.			

PUMP DATA		
PUMP TYPE (Circle One): Submersible, Turbine, <input checked="" type="radio"/> Jet, Flowing Well, Other (Describe) _____		
POWER TYPE (Circle One): <input checked="" type="radio"/> Electric, Tractor, Diesel, Gasoline, Butane, Other (Describe) _____ H/P _____		
Pump Capacity (GPM) 12	No. of Stages 2	Setting Depth 50' FT.
PUMP TEST Well yielded 12 GPM with a drawdown of 10 ft. after 1 hours of pumping		

WELL DATA		
Well Depth 830	Casing Diameter (In.) 2"	Casing Length (Ft.) 20'
Type of Casing Pvc	Hole Depth 830	Depth to Static Water Level 30'
TYPE OF COMPLETION: (Circle One or More): <input checked="" type="checkbox"/> Gravel Packed, <input type="checkbox"/> Underreamed, <input type="checkbox"/> Telescoped, <input checked="" type="checkbox"/> Natural Development, <input type="checkbox"/> Open Hole, <input type="checkbox"/> Other (Describe) _____		
Top of Lap Pipe or Reduction in Casing FEET IF TELESCOPED OR MORE THAN ONE SCREEN: USE BACK PAGE		

LOG DATA	
TYPE OF LOG RUN (Circle One): Electric, Gamma Ray, Density, Sonic, <input checked="" type="radio"/> No Log Run, Neutron, Other (Describe) _____	
Name of Organization Running Log	

SCREEN DATA		
Diameter - Inches 2"	Length - Feet 10'	Slot Size - Inches .0006
Screen Type Pvc	Depth to Bottom - Feet 830'	

GEOLOGIC DATA (Office Use Only)			
Surface Elev.	Geologic Unit	Unit Thickness	Depth to Top
Subs. SWL	Date	Analysis	Aquifer Test

Driller's Remarks	

DESCRIPTION OF FORMATIONS ENCOUNTERED	FROM	TO	FORMATIONS (Continued)	FROM	TO
mud	0	60	sand	750	830
sand	60	90			
mud	90	160			
sand	160	190			
mud	190	280			
sand	280	290			
mud	290	420			
sand	420	440			
mud	440	610			
sand	610	620			
mud	620	750			

RECEIVED


AUG 16 1990

**Department of Natural Resources
Bureau of Land & Water Resources**

IF MORE SPACE IS NEEDED, USE BACK

If well telescopes please sketch and show depths.

GROUND LEVEL

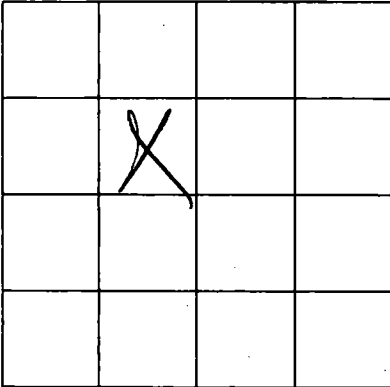

SECTION _____

Please indicate well location X.

ADDITIONAL INFORMATION

Lined area for additional information.

If more than one screen, show location of each on sketch.