

MISSISSIPPI DEPARTMENT OF ENVIRONMENTAL QUALITY

Office of Land and Water Resources

P. O. Box 10631
Jackson, MS 39289-0631
WATER WELL DRILLERS LOG

COUNTY WELL LOCATED Narrison	
WELL NUMBER N-2145	CODED
DATE WELL COMPLETED 8-17-01	

PERMIT NUMBER
NAME OF DRILLING FIRM McGill Pump & Well

NAME & MAILING ADDRESS OF LANDOWNER Donald Davenport 2050 Red Oak Rd. Bossier, MS 39574			
Latitude: Longitude:			
WELL LOCATION	SEC 5	TOWNSHIP 8 N	RANGE 13 E
DISTANCE 15 Miles	DIRECTION W	NEAREST TOWN Opf	
OTHER LANDMARK			
WELL PURPOSE: <input checked="" type="radio"/> Home, <input type="radio"/> Irrigation, <input type="radio"/> Municipal, <input type="radio"/> Industrial, <input type="radio"/> Fish Pond, etc.			

PUMP DATA		
PUMP TYPE (Circle One): <input checked="" type="radio"/> Submersible, <input type="radio"/> Turbine, <input type="radio"/> Jet, <input type="radio"/> Flowing Well, Other (Describe)		
POWER TYPE (Circle One): <input checked="" type="radio"/> Electric, <input type="radio"/> Tractor, <input type="radio"/> Diesel, <input type="radio"/> Gasoline, <input type="radio"/> Butane, Other (Describe) H/P 1/2		
DESCRIPTION OF FORMATIONS ENCOUNTERED	FROM	TO
Mud	0	20
Sand	20	40
Mud	40	260
Sand	260	280
Mud	280	360
Sand	360	380

WELL DATA		
Well Depth 380'	Casing Diameter (In.) 4" x 2"	Casing Length (Ft.) 360'
Type of Casing PVC	Hole Depth 380'	Depth to Static Water Level 115'
TYPE OF COMPLETION: (Circle One or More): <input checked="" type="radio"/> Gravel Packed, <input type="radio"/> Underreamed, <input type="radio"/> Telescoped, <input checked="" type="radio"/> Natural Development, <input type="radio"/> Open Hole, <input type="radio"/> Other (Describe)		

WELL GROUTED TO A DEPTH OF 10 FEET Type Grout (circle one): <input checked="" type="radio"/> Cement, <input type="radio"/> Bentonite, or Mix
--

SCREEN DATA		
Diameter - Inches 2"	Length - Feet 20'	Slot Size - Inches .006
Screen Type PVC	Depth to Bottom - Feet 380'	

RECEIVED		
SEP 21 2001		
Dept. of Environmental Quality Office of Land & Water Resources		
Top of Lap Pipe or Reduction in Casing		
FEET	IF TELESCOPED OR MORE THAN ONE SCREEN: USE BACK PAGE	

I certify that the well was drilled, constructed and completed in accordance with all applicable Requirements of the Mississippi Department of Environmental Quality and/or the Mississippi Department of Health regulations and state laws.


Michael M. Hill O-239
Signature of Licensed Driller and License No.

9-14-01
Date

Additional Information Required On Back

If well telescopes please sketch and show depths.

GROUND LEVEL

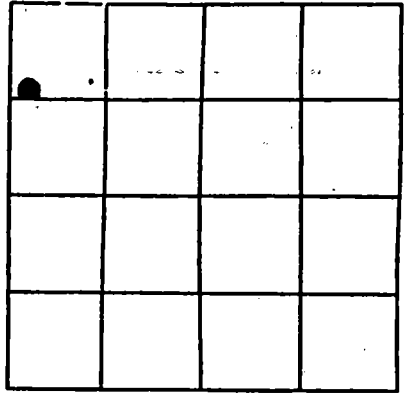

SECTION _____

Please indicate well location X.

Pump Capacity (GPM)	No. of Stages	Setting Depth
30	10	200' FT.

PUMP TEST

Well yielded 30 GPM with
 a drawdown of 5 ft.
 after 5 hours of pumping

LOG DATA

TYPE OF LOG RUN (Circle One): No Log Run, Electric, Gamma Ray, Density, Sonic, Neutron, Other (Describe) handwritten

Name of Organization Running Log

GEOLOGIC DATA (Office Use Only)

Surface Elev.	Geologic Unit	Unit Thickness	Depth to Top
Subs. SWL	Date	Analysis	Aquifer Test

Driller's Remarks

If more than one screen, show location of each on sketch.