

MISSISSIPPI DEPARTMENT OF ENVIRONMENTAL QUALITY

Office of Land and Water Resources

P. O. Box 10631
Jackson, MS 39289-0631
WATER WELL DRILLERS LOG

COUNTY WELL LOCATED Harrison	
WELL NUMBER N-2146	CODED
DATE WELL COMPLETED 8-27-01	

PERMIT NUMBER
NAME OF DRILLING FIRM McGill Pump & Well

NAME & MAILING ADDRESS OF LANDOWNER Clearance Padroll 6226 hand rd. Pass Christian, MS 39571			
Latitude: Longitude:			
WELL LOCATION	SEC	TOWNSHIP	RANGE
	2	8	S 13 W
DISTANCE /	DIRECTION	NEAREST TOWN	
2 1/2 Miles	N	of Pass Chris.	
OTHER LANDMARK			
WELL PURPOSE (Circle one) <input checked="" type="radio"/> Irrigation, <input type="radio"/> Municipal, <input type="radio"/> Industrial, <input type="radio"/> Fish Pond, etc.			

PUMP DATA	
PUMP TYPE (Circle One): Submersible, Turbine, <input checked="" type="radio"/> Jet, <input type="radio"/> Flowing Well, Other (Describe) _____	
POWER TYPE (Circle One): <input checked="" type="radio"/> Electric, <input type="radio"/> Tractor, <input type="radio"/> Diesel, <input type="radio"/> Gasoline, <input type="radio"/> Butane, Other (Describe) _____ H/P 1	

DESCRIPTION OF FORMATIONS ENCOUNTERED	FROM	TO
mud	0	20
sand	20	60
mud	60	220
sand	220	260
mud	260	440
sand	440	460
mud	460	480
sand	480	540

WELL DATA		
Well Depth 540'	Casing Diameter (In.) 2"	Casing Length (Ft.) 520'
Type of Casing PVC	Hole Depth 540'	Depth to Static Water Level 20'
TYPE OF COMPLETION: (Circle One or More): <input checked="" type="radio"/> Gravel Packed, <input type="radio"/> Underreamed, <input type="radio"/> Telescoped, <input checked="" type="radio"/> Natural Development, <input type="radio"/> Open Hole, <input type="radio"/> Other (Describe) _____		

RECEIVED

SEP 21 2001

Dept. of Environmental Quality
Office of Land & Water Resources

WELL GROUTED TO A DEPTH OF 10 FEET Type Grout (circle one): <input checked="" type="radio"/> Cement, <input type="radio"/> Bentonite, or Mix
--

SCREEN DATA		
Diameter - Inches 2"	Length - Feet 20'	Slot Size - Inches 1006
Screen Type PVC	Depth to Bottom - Feet 540'	

Top of Lap Pipe or Reduction in Casing
FEET
IF TELESCOPED OR MORE THAN ONE SCREEN: USE BACK PAGE

I certify that the well was drilled, constructed and completed in accordance with all applicable Requirements of the Mississippi Department of Environmental Quality and/or the Mississippi Department of Health regulations and state laws.


Michael McGill 0-239
Signature of Licensed Driller and License No.

9-14-01
Date

Additional Information Required On Back

If well telescopes please sketch and show depths.

GROUND LEVEL

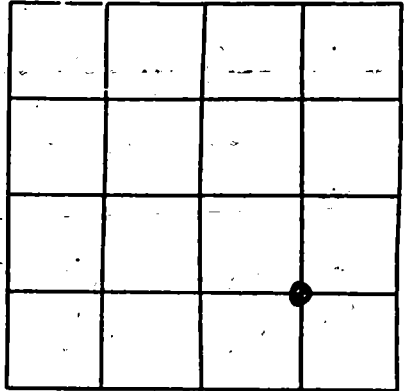

SECTION _____

Please indicate well location X.

Pump Capacity (GPM) <u>8</u>	No. of Stages <u>2</u>	Setting Depth <u>40'</u> FT.
---------------------------------	---------------------------	---------------------------------

PUMP TEST

Well yielded 8 GPM with
a drawdown of 5 ft.
after 5 hours of pumping

LOG DATA

TYPE OF LOG RUN (Circle One): No Log Run, Electric, Gamma Ray, Density, Sonic, Neutron, Other (Describe) handwritten

Name of Organization Running Log

GEOLOGIC DATA (Office Use Only)

Surface Elev.	Geologic Unit	Unit Thickness	Depth to Top
Subs. SWL	Date	Analysis	Aquifer Test

Driller's Remarks

If more than one screen, show location of each on sketch.