
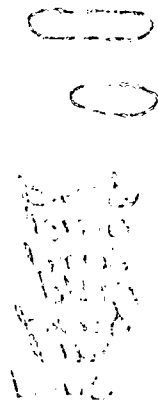


If well telescopes please sketch and show depths.

GROUND LEVEL

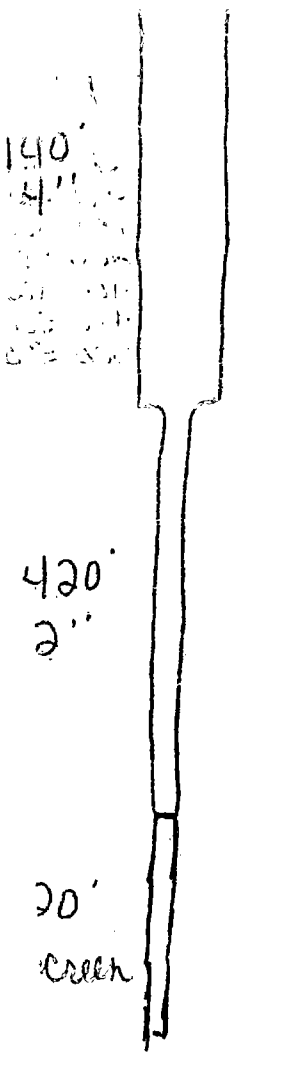

420'
2"
creek

If more than one screen, show location of each on sketch.

1100	1100	1100	1100
1100	1100	1100	1100
1100	1100	1100	1100
1100	X	1100	1100

SECTION _____

Please indicate well location X.

Pump Capacity (GPM)	No. of Stages	Setting Depth
18	10	60 FT.

PUMP TEST

Well yielded 18 GPM with
a drawdown of 15 ft.
after 12 hours of pumping

LOG DATA

TYPE OF LOG RUN (Circle One): No Log Run
Electric, Gamma Ray, Density, Sonic, Neutron,
Other (Describe) _____

Name of Organization Running Log

GEOLOGIC DATA (Office Use Only)

Surface Elev.	Geologic Unit	Unit Thickness	Depth to Top
Subs. SWL	Date	Analysis	Aquifer Test

Driller's Remarks
