

**MISSISSIPPI DEPARTMENT OF ENVIRONMENTAL
QUALITY**

Office of Land and Water Resources

P. O. Box 10631
Jackson, MS 39289-0631
WATER WELL DRILLERS LOG

COUNTY WELL LOCATED
HARRISON

WELL NUMBER CODED
N-2163

DATE WELL COMPLETED
FEB 18, 02

PERMIT NUMBER

NAME OF DRILLING FIRM
M + M WELL

NAME & MAILING ADDRESS OF LANDOWNER
CLASSIC HOMES
HANLEY RD

Latitude:
Longitude:

WELL LOCATION. SEC T21 TOWNSHIP 8 N RANGE 13 E

DISTANCE 1 Miles S DIRECTION of Lug Beach NEAREST TOWN

OTHER LANDMARK
1 mile from River walk

WELL PURPOSE (Mining, Irrigation, Municipal, Industrial, Fish Ponds, etc.)

PUMP DATA

PUMP TYPE (Circle One):
Submersible, Turbine, (Jet) Flowing Well,
Other (Describe)

POWER TYPE (Circle One):
(Electric) Tractor, Diesel, Gasoline, Butane,
Other (Describe) H/P 1

DESCRIPTION OF FORMATIONS ENCOUNTERED	FROM	TO
<u>Red CLAY</u>	<u>1</u>	<u>30</u>
<u>SANDY CLAY</u>	<u>30</u>	<u>20</u>
<u>GREEN CLAY</u>	<u>120</u>	<u>295</u>
<u>SAND</u>	<u>245</u>	<u>290</u>

RECEIVED
MAR 30 2002
OLWR

Top of Lap Pipe or Reduction in Casing

FEET	IF TELESCOPED OR MORE THAN ONE SCREEN: USE BACK PAGE
-------------	------------------------------------------------------

WELL DATA

Well Depth <u>280'</u>	Casing Diameter (In.) <u>2"</u>	Casing Length (Ft.) <u>270'</u>
Type of Casing <u>PVC</u>	Hole Depth <u>280'</u>	Depth to Static Water Level <u>70'</u>

TYPE OF COMPLETION: (Circle One or More):
Gravel Packed, Natural Development, Underreamed, Telescoped, Open Hole, Other

WELL GROUTED TO A DEPTH OF 10 FEET
Type Grout (circle one): Cement, Bentonite, or Mix

SCREEN DATA

Diameter - Inches <u>2"</u>	Length - Feet <u>10'</u>	Slot Size - Inches <u>006</u>
Screen Type <u>PVC</u>	Depth to Bottom - Feet <u>270-280</u>	


I certify that the well was drilled, constructed and completed in accordance with all applicable Requirements of the Mississippi Department of Environmental Quality and/or the Mississippi Department of Health regulations and state laws.

Alex Maddox 0563
Signature of Licensed Driller and License No.

APR 29, 02
Date

If well telescopes please sketch and show depths.

GROUND LEVEL

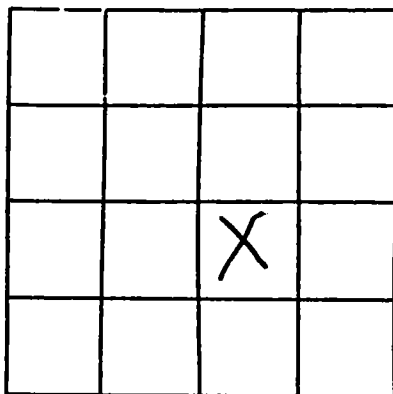

SECTION 18

Please indicate well location X.

Pump Capacity (GPM) <u>600</u>	No. of Stages <u>2</u>	Setting Depth <u>90'</u> FT.
-----------------------------------	---------------------------	---------------------------------

PUMP TEST

Well yielded 16 GPM with
a drawdown of 5 feet ft.
after _____ hours of pumping

LOG DATA

TYPE OF LOG RUN (Circle One): No Log Run, Electric, Gamma Ray, Density, Sonic, Neutron, Other (Describe) _____

Name of Organization Running Log

GEOLOGIC DATA (Office Use Only)

Surface Elev.	Geologic Unit	Unit Thickness	Depth to Top
Subs. SWL	Date	Analysis	Aquifer Test

Driller's Remarks

If more than one screen, show location of each on sketch.