

HAR.
N

MISSISSIPPI BOARD OF WATER COMMISSIONERS

B 23712
WATER WELL DRILLERS LOG

(29) (9)

8-16-60

Date Aug 16, 1960, Driller C. J. Switzer Wells County
(Name)

(1) Owner of Land: George Jig
(Name)
on Duncan and
Cherokee Rd.
(Address)

(2) Location: 1/4, 1/4, Sec. T R
 miles, of
(distance) (direction) (Nearest Town)

(3) Topography: (Level)
(Hilly) (Flat)

(4) Purpose of Well: domestic
(Domestic Irrigation
Municipal, Industrial, Other)

Description & Color of Materials Sand, Clay, Red Clay, Shell, etc.	Thick- ness Feet	Depth Feet
<u>Clay</u>		<u>14</u>
<u>sand</u>	<u>14</u>	<u>25</u>
<u>Clay</u>	<u>25</u>	<u>65</u>
<u>sand</u>	<u>65</u>	<u>103</u>
<u>Clay</u>	<u>103</u>	<u>168</u>
<u>sand</u>	<u>168</u>	<u>194</u>


Information upon completion of well:

- (1) Diameter 2 inches.
- (2) Total Depth 194' feet.
- (3) Water Level ground level feet below top of ground.
- (4) Cased to 194', Size 2"
- (5) Screen: Size 8 gals Length 2" x 10"
- (6) Were any formations sealed against pollution?
 yes, no.

If YES depth of formation 10 feet

Why Health Dept. requirements

Drillers Remarks:

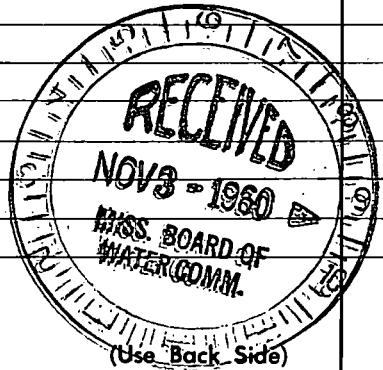

Well No.

