

HAR.
N

MISSISSIPPI BOARD OF WATER COMMISSIONERS

WATER WELL DRILLERS LOG

?

5-12-61


Date: May 12, 1961, Driller: C. E. Switzer Well Co County Harrison
(Name)

(1) Owner of Land:	Description & Color of Materials Sand, Clay, Red Clay, Shell, etc.	Thick- ness Feet	Depth Feet
<u>Mrs. L. Logan</u> (Name)	Clay	0	10
<u>101 W. West Beach</u> (Address)	Sand	10	20
(2) Location: _____ 1/4, _____ 1/4, Sec. _____ T. _____ R. _____	Clay	20	41
_____ miles _____ of _____ (distance) (direction) (Nearest Town)	label	41	83
(3) Topography: _____ (Hilly) (Flat) (Level)	Clay	83	104
(4) Purpose of Well: <u>Domestic</u> (Domestic Irrigation Municipal, Industrial, Other)	Sand & Clay streak	104	125
	Sand	125	156
	Clay	156	272
	Clay & sand streak	272	293
	Sand	293	303
	Clay	303	335
	Sand	335	364

Information upon completion of well:

- (1) Diameter 2" inches.
- (2) Total Depth 364 feet.
- (3) Water level 10' feet below top of ground.
- (4) Cased to 364, Size 2"
- (5) Screen: Size 2", Length 10'
- (6) Were any formations sealed against pollution?
X yes, _____ no.

If YES depth of formation _____
 Why Health Dept Requirement
 Drillers Remarks: _____

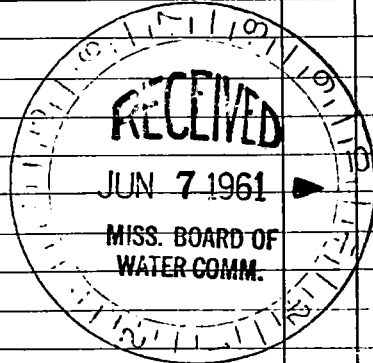

(Use Back Side)

Well No.

Handwritten text at the top of the page, possibly a title or header.

Vertical list of handwritten numbers or characters on the left side.

Vertical list of handwritten text or symbols in the middle-left section.

Handwritten text in the upper right quadrant.

Handwritten text in the middle-right section.

Handwritten text in the lower right quadrant.

Handwritten text at the bottom of the page.