

HAR.

MISSISSIPPI BOARD OF WATER COMMISSIONERS

N

6-28-61

WATER WELL DRILLERS LOG

Date: 6-28, 1961, Driller: Sutter Well Wash County Harrison

(Name)

(1) Owner of Land: Dr. Geo. Sustental
 (Name)
1424 Amelia St. - N.O. La.
 (Address)

(2) Location: 1/4, 1/4, Sec. T R,
3 miles N, of Paris,
 (distance) (direction) (Nearest Town)

(3) Topography: flat
 (Hilly) (Flat) (Level)

(4) Purpose of Well: domestic
 (Domestic Irrigation
 Municipal, Industrial, Other)

Description & Color of Materials Sand, Clay, Red Clay, Shell, etc.	Thick- ness Feet	Depth Feet
Surface sand (some gravel)	60	60
Clay	165	225
sand	23	248
Clay	105	353
sand	52	405
Clay	129	534
sand	66	600

Information upon completion of well:

(1) Diameter 2 inches.

(2) Total Depth 600 feet.

(3) Water Level 21 feet above below top of ground.

(4) Cased to all, Size 2"


(5) Screen: Size 2", Length 20'

(6) Were any formations sealed against pollution?
 _____ yes, no.

If YES depth of formation _____

Why _____

Drillers Remarks: _____

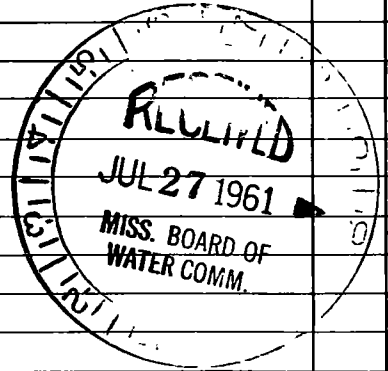

(Use Back Side)

Well No.

