

HAR.


N

WATER WELL DRILLERS LOG

7-12-61

Date: July 12, 1961, Driller: C. T. SWITZER WELL CO County Harrison
(Name)

(1) Owner of Land: <u>Ronald Peabingough</u> (Name)	Description & Color of Materials Sand, Clay, Red Clay, Shell, etc.	Thick- ness Feet	Depth Feet
<u>35 Carolyn Drive</u> (Address)	clay	0	38
(2) Location: <u>1/4</u> , <u>1/4</u> , Sec. <u>1</u> T. <u>1</u> R. <u>1</u>	sand	38	47
<u>1/4</u> miles <u>N</u> of <u>1</u> (distance) (direction) (Nearest Town)	clay	47	62
(3) Topography: <u>X</u> (Hilly) (Flat) (Level)	sand	62	76
(4) Purpose of Well: <u>Domestic</u> (Domestic Irrigation Municipal, Industrial, Other)	clay	76	167
Information upon completion of well:	sand	167	172
(1) Diameter <u>2"</u> inches.	clay	172	188
(2) Total Depth <u>744'</u> feet.	sand	188	198
(3) Water Level <u>4'</u> feet below top of ground.	clay	198	356
(4) Cased to <u>744'</u> , Size <u>2"</u>	sand	356	371
(5) Screen: Size <u>2"</u> , Length <u>10'</u>	clay	371	503
(6) Were any formations sealed against pollution? <u>X</u> yes, <u> </u> no.	sand	503	508
If YES depth of formation _____	clay	508	524
Why <u>Health Dept Requirement</u>	sand	524	534
Drillers Remarks: _____	clay	534	702
_____	sand	702	744

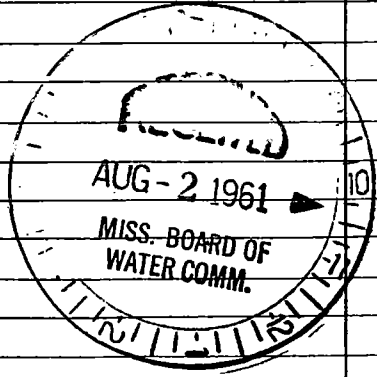

(Use Back Side)

Well No.

AT NEW BOSTON N. H.

1	10
2	10
[Faint, mostly illegible handwritten text, possibly a list or ledger entries.]

[Faint handwritten text at the bottom of the page, possibly a signature or date.]