

HAR.

MISSISSIPPI BOARD OF WATER COMMISSIONERS

N

D 2838

N 322

9-28-61

WATER WELL DRILLERS LOG

Date: 9-28, 1961, Driller: Sutter Well Works County Harrison

(Name)

(1) Owner of Land: G.A. Needham (Name)

1201 Pass Rd - Hueffert (Address)

(2) Location: 1/4 Sec. T R, Sutter, Okla. (distance) miles, direction, P. Clinton (Nearest Town)

(3) Topography: flat (Hilly) Flat (Level)

(4) Purpose of Well: domestic (Domestic Irrigation Municipal, Industrial, Other)

Description & Color of Materials Sand, Clay, Red Clay, Shell, etc.	Thick- ness Feet	Depth Feet
Clay	15	15
Sand & gravel	30	45
Clay	97	142
sand	30	172


Information upon completion of well:

- (1) Diameter: 2 inches.
- (2) Total Depth: 172 feet.
- (3) Water level: 1/2 feet above below top of ground.
- (4) Cased to: all, Size: 2"
- (5) Screen: Size: 2", Length: 5'
- (6) Were any formations sealed against pollution?
yes, no.

If YES depth of formation

Why

Drillers Remarks:

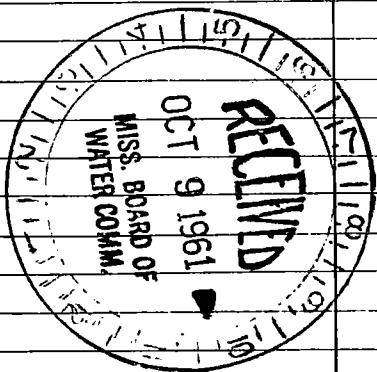

(Use Back Side)

Well No.

