

HAR.

MISSISSIPPI BOARD OF WATER COMMISSIONERS

N

N-302

10-18-61

WATER WELL DRILLERS LOG

Date: 10-18, 1961, Driller: J. Beale County Harrison

(Name)

(1) Owner of Land: E Ellington

(Name)

Rt 1 Box 44 Dan Christian

(Address)

(2) Location: 1/4, 1/4, Sec. T R

Next Door to school. miles of (distance) (direction) (Nearest Town)

(3) Topography: (Hilly) (Flat) (Level)

(4) Purpose of Well: Home (Domestic Irrigation Municipal, Industrial, Other)

Description & Color of Materials Sand, Clay, Red Clay, Shell, etc.	Thick- ness Feet	Depth Feet
White sand	40	40
Soft mud	63	103
Hard Blue mud	69	172
Coarse artesian sand	18	190
Well		190

Information upon completion of well:

(1) Diameter 2 x 1 1/4 inches.

(2) Total Depth 190 feet.

(3) Water Level 8 feet below top of ground.

(4) Cased to, Size

(5) Screen: Size, Length

(6) Were any formations sealed against pollution?


yes, no.

If YES depth of formation

Why

Drillers Remarks:

Beck filled with sand

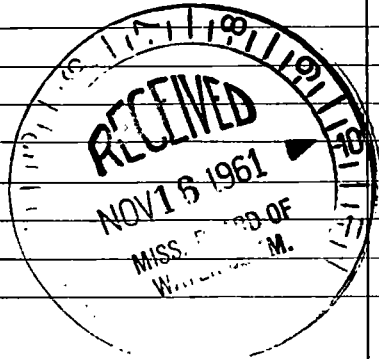

(Use Back Side)

Well No.

