

HAR.

N

10-24-63

WATER WELL DRILLERS LOG

Archie?

Hancock

Date: Oct 24, 1963

Driller: Joe Miller

(Name)

County: Hancock

(1) Owner of Land: Fred Scarborough (Name)

Henderson Ave, Pass Christian (Address)

(2) Location: 1/4, 1/4, Sec. T R

1 miles North of Pass Christian (distance) (direction) (Nearest Town)

(3) Topography: Flat (Hilly) (Flat) (Level)

(4) Purpose of Well: Domestic (Domestic Irrigation Municipal, Industrial, Other)

Description & Color of Materials Sand, Clay, Red Clay, Shell, etc.	Thick- ness Feet	Depth Feet
Surface	3	3
Brown Clay	2	5
Blue Clay	30	35
White Sand (Coarse)	27	62
Blue Clay	74	138
Brck. (Fine Gray Sand)	24	162
Blue Clay	12	174
Brck. Fine Sand	11	185
Blue Clay	8	193
Sand + Shells (Fine)	17	210
Brck. Fine Gray Sand	18	228
Clay + Sand (Thin) Wk	55	283
Hard Blue Clay	23	306
Fine Gray Sand	42	348
Hard Blue Clay	52	400
Fine Sand, Gray	10	410
Brck. - (Hard) (Coarse)	11	421
Sand - Fair	10	431
Sand Fair	6	437
Clay, (Hard)	3	440

Information upon completion of well:

(1) Diameter 2" inches.

(2) Total Depth 440 feet. 40 gal water, etc.

(3) Water Level Flowing, 427 feet below top of ground.

(4) Cased to 427, Size 2"


(5) Screen: Size 2", Length 10'

(6) Were any formations sealed against pollution? yes, no. [checked]

If YES depth of formation

Why

Drillers Remarks:

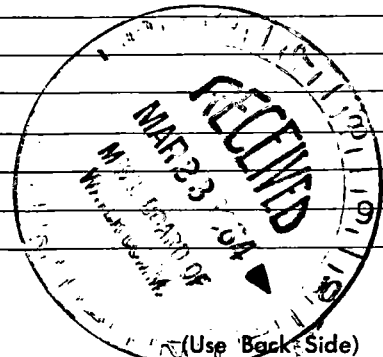

Well No.

Handwritten notes on the left side of the page, including the number '10' and various illegible scribbles.

Main body of handwritten text in the center, consisting of several lines of cursive script that are mostly illegible.

Handwritten text at the top right, possibly a header or a specific note, including the word 'L'.

Handwritten text in the middle right section, appearing as a separate line or phrase.

Handwritten text at the bottom right, including the number '9' and other illegible characters.

Handwritten text at the bottom left, possibly a signature or a date.