

HAR:

N

9-9-64

WATER WELL DRILLERS LOG

Date: 9-9, 1964, Driller: Hattiesburg Butane County Harrison

(Name)

(1) Owner of Land: Curvis Ladner

(Name)

Rt 1 Paul Christian

Deddy comm.

(Address)

(2) Location: 1/4, 1/4, Sec. 29.512

P T R

miles of (distance) (direction) (Nearest Town)

(3) Topography: X

(Hilly) (Flat) (Level)

(4) Purpose of Well: Domestic

(Domestic Irrigation Municipal, Industrial, Other)

Information upon completion of well:

(1) Diameter 2 inches.

(2) Total Depth 130 feet.

(3) Water Level 31 feet below top of ground.

(4) Cased to, Size

(5) Screen: Size 2", Length 10'

(6) Were any formations sealed against pollution?


yes, X no.

If YES depth of formation

Why

Drillers Remarks:

Description & Color of Materials Sand, Clay, Red Clay, Shell, etc.	Thick- ness Feet	Depth Feet
Red clay	0-	30
Blue clay	30-	120
Blue sand	120-	130

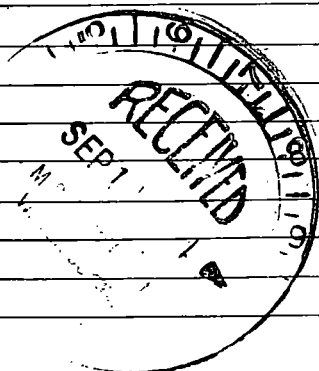

(Use Back Side)

Well No.

