

2-6-64 WATER WELL DRILLERS LOG

Date: 2-6-1964, Driller: C. T. SWITZER WELL CO. County: Harrison

(1) Owner of Land: East Waterworks, Inc
 (Name)
Daughterly Park Sub, Long Beach
 (Address)

(2) Location: 1/4, 1/4, Sec. 2 T8R12W
 _____ miles _____ of _____
 (distance) (direction) (Nearest Town)

(3) Topography: Level
 (Hilly) (Flat) (Level)

(4) Purpose of Well: Commercial
 (Domestic Irrigation
 Municipal, Industrial, Other)

Description & Color of Materials Sand, Clay, Red Clay, Shell, etc.	Thick- ness Feet	Depth Feet
SAND	00	21
CLAY	21	35
SAND	35	43
CLAY	43	59
SAND	59	109
CLAY	109	125
SAND & STKS	125	135
SAND	135	171
CLAY	171	214
SAND	214	230
CLAY	230	246
SAND <u>COARSE</u>	246	260
SHALE	260	268
SHALE w/ SAND STKS	268	290
SAND & SHALE	290	334
SHALE	334	357
SHALE w/ SAND STKS	357	379
SHALE	379	439
SAND	439	476
SHALE	476	532
SAND	532	590

Information upon completion of well:

(1) Diameter 12 1/2 inches.

(2) Total Depth 590 feet.

(3) Water Level 4' feet below top of ground.

(4) Cased to 590', Size 12 1/2"


(5) Screen: Size 8", Length 40'

(6) Were any formations sealed against pollution?
 yes, _____ no.

If YES depth of formation _____

Why Health Dept. requirement

Drillers Remarks: _____

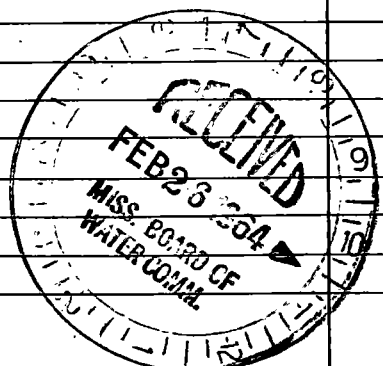

(Use Back Side)

Well No.

