

MISSISSIPPI
BOARD OF WATER COMMISSIONERS
416 North State Street
Jackson, Mississippi 39201

CODED

WATER WELL DRILLERS LOG

Harrison
14
4-67
Elec Log
4-5

1967 Sutter Well Works Harrison
date well completed firm name county well located

LANDOWNER: H. H. Crosby

Pass Christian,
Miss.
(mailing address)

WELL LOCATION:

sec. 8 T. 30 N. R. 12 E
S
miles 1/2 IN Pass Christian
(distance) (direction) (nearest town)

WELL PURPOSE: home
(home, irrigation, municipal, industrial)

WELL COMPLETION DATA:


- (1) diameter (inches) 6
- (2) total depth (feet) 889
- (3) static water level (feet) 2 ^{below} above top of ground.
- (4) casing Galv steel 849'
(material) (depth)
6" if telescope see back.
(size)
- (5) screen 40' 849'
(length) (depth to top)
6" stainless steel
(size) (material)
- (6) pump 5 300
(HP) (yield gpm)
elec.
(type power)
- (7) electric log yes
(yes or no)
U.S. G.S.
(organization running log)
- (8) how well bottom plugged B.P. Value

description of formations encountered

from to

<u>sand</u>	<u>0</u>	<u>30</u>
<u>clay</u>	<u>30</u>	<u>48</u>
<u>sand</u>	<u>48</u>	<u>83</u>
<u>clay</u>	<u>83</u>	<u>280</u>
<u>soft clay - fine sand</u>	<u>280</u>	<u>400</u>
<u>clay</u>	<u>400</u>	<u>515</u>
<u>sand</u>	<u>515</u>	<u>543</u>
<u>clay</u>	<u>543</u>	<u>610</u>
<u>sand</u>	<u>610</u>	<u>625</u>
<u>clay</u>	<u>625</u>	<u>790</u>
<u>sand</u>	<u>790</u>	<u>889</u>

CODED

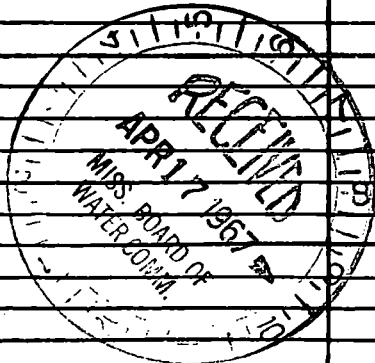

DRILLERS REMARKS:

If well telescopes please sketch and show depths.

GROUND LEVEL

60' of 10" upper casing

Cemented between 6" and 10" casing

849' of 6" casing to top of ground

40' of stainless steel strainer 6" size

SECTION _____

Please indicate well location X.

ADDITIONAL INFORMATION

If more than one screen, show locations of each on sketch.