

Harrison
 017
 8-68

MISSISSIPPI
 BOARD OF WATER COMMISSIONERS
 416 North State Street
 Jackson, Mississippi 39201

CODED

WATER WELL DRILLERS LOG

August 2, 1968 Ladner's Well Works, Harrison Co.
 date well completed firm name county well located

LANDOWNER: Mr. Johnson
Pineville Road,
Long Beach, Miss.
 (mailing address)

description of formations encountered	from	to
<u>Yellow clay</u>	<u>0</u>	<u>20</u>
<u>White Sand</u>	<u>20</u>	<u>80</u>
<u>Mixed Red Clay + Sand</u>	<u>80</u>	<u>160</u>
<u>Blue Clay</u>	<u>160</u>	<u>300</u>
<u>Coarse Blue Sand</u>	<u>300</u>	<u>340</u>


WELL LOCATION:
 sec. 9 T. 8 N. R. 12 E.
 (S) (W)
2 miles NW of Long Beach
 (distance) (direction) (nearest town)

WELL PURPOSE: HOME
 (home, irrigation, municipal, industrial)

WELL COMPLETION DATA:


- (1) diameter (inches) 2 inch
- (2) total depth (feet) 340 feet
- (3) static water level (feet) 88 below
 top of ground.
- (4) casing 130 ft. Galvanized
 (material) (depth) pipe
2 inch If telescope see back.
 (size)
- (5) screen 10 ft., 130 ft.
 (length) (depth to top)
- 2 inch, 55
 (size) (material)
- (6) pump 1/2 5
 (HP) (yield gpm)
- Electric
 (type power)
- (7) electric log no
 (yes or no)
- (organization running log)
- (8) how well bottom plugged
Ball Check

DRILLERS REMARKS:

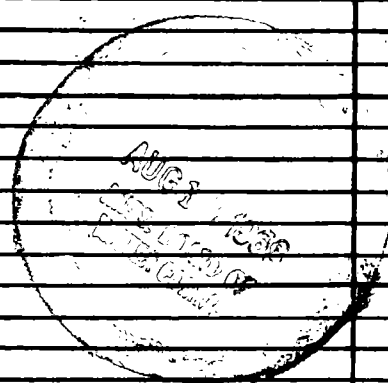

If well telescopes please sketch and show depths.

GROUND LEVEL

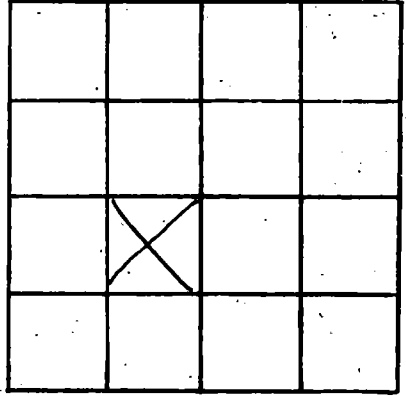

SECTION 9

Please indicate well location X.

ADDITIONAL INFORMATION

If more than one screen, show locations of each on sketch.