

Harrison
019
8-68

MISSISSIPPI
BOARD OF WATER COMMISSIONERS
416 North State Street
Jackson, Mississippi 39201

CODED

WATER WELL DRILLERS LOG

8-14 1968 date well completed
Sutter Well Works firm name
Harrison county well located

LANDOWNER: J. K. BYRNE

Morgan Ave.
Pass Christian, Miss
(mailing address)

WELL LOCATION:

sec. 8 T. 8 S. R. 17 E. W.
1.1 miles (distance) of Crenshaw (direction) (nearest town)

WELL PURPOSE: home
(home, irrigation, municipal, industrial)


WELL COMPLETION DATA:

- (1) diameter (inches) 2
- (2) total depth (feet) 578
- (3) static water level (feet) 1 below top of ground.
- (4) casing Galv. 568' (material) (depth)
2" (size) If telescope see back.
- (5) screen 10' 568' (length) (depth to top)
2" (size) Stainless Steel (material)
- (6) pump Unknown (HP) (yield gpm)
(type power)
- (7) electric log No (yes or no)
(organization running log)
- (8) how well bottom plugged B.P. Valve

description of formations encountered

from to

Sand	0	95
Clay	95	238
Sand	238	253
Clay	253	327
Sand	327	349
Clay	349	550
Sand	550	578

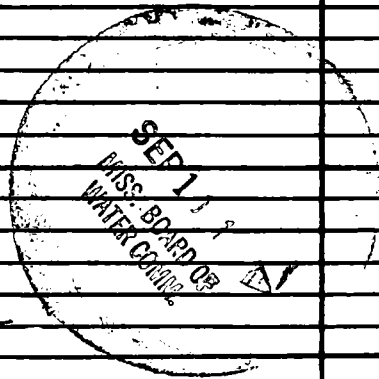

DRILLERS REMARKS:

If well telescopes please sketch and show depths.

GROUND LEVEL

*			

SECTION 8

Please indicate well location X.

ADDITIONAL INFORMATION

If more than one screen, show locations of each on sketch.