

Harrison  
020  
8-68

MISSISSIPPI  
BOARD OF WATER COMMISSIONERS  
416 North State Street  
Jackson, Mississippi 39201

CODED

WATER WELL DRILLERS LOG

8-15 1968 Sutter Well Works Harrison  
date well completed firm name county well located

LANDOWNER: C.A. DuBUISSON

description of formations encountered

from to

Orange Ave  
Pass Christian Miss.  
(mailing address)

<u>Sand</u>	<u>0</u>	<u>35</u>
<u>Clay</u>	<u>35</u>	<u>76</u>
<u>Sand</u>	<u>76</u>	<u>95</u>
<u>Clay, Sand etc.</u>	<u>95</u>	<u>550</u>
<u>Sand</u>	<u>550</u>	<u>579</u>

WELL LOCATION:


sec 8 T 8 N R 18 W  
S W  
miles 1 1/2 of Greenville  
(distance) (direction) (nearest town)

WELL PURPOSE: home  
(home, irrigation, municipal, industrial)

WELL COMPLETION DATA:


- (1) diameter (inches) 2
- (2) total depth (feet) 579
- (3) static water level (feet) 1 ~~below~~ above top of ground.
- (4) casing galv. 569'  
(material) (depth)  
2" if telescope see back.  
(size)
- (5) screen 10' 569'  
(length) (depth to top)  
2" Stainless Steel  
(size) (material)
- (6) pump unknown  
(HP) (yield gpm)  
(type power)
- (7) electric log no  
(yes or no)  
(organization running log)
- (8) how well bottom plugged BP Valve

DRILLERS REMARKS:

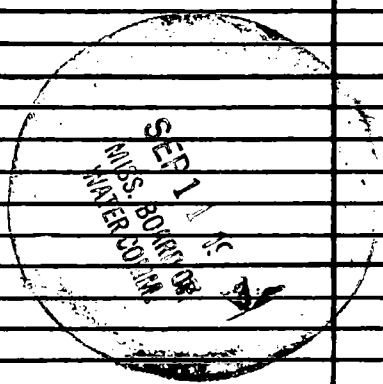

If well telescopes please sketch and show depths.

GROUND LEVEL

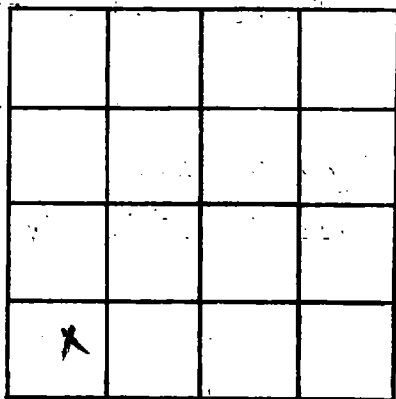

SECTION 8

Please indicate well location X.

ADDITIONAL INFORMATION

If more than one screen, show locations of each on sketch.