

Harrison  
 022  
 8-12-68

MISSISSIPPI  
 BOARD OF WATER COMMISSIONERS  
 416 North State Street  
 Jackson, Mississippi 39201

CODED

WATER WELL DRILLERS LOG

8-12 1968 Sutter Well Works Harrison  
 date well completed firm name county well located


LANDOWNER: Elton Spier  
 Orange Ave.  
 Pass Christian Miss.  
 (mailing address)

description of formations encountered	from	to
Sand	0	83
Clay	83	231
Sand	231	256

WELL LOCATION:  
 sec. 8 T. 8 N. R. 4 E.  
 S W  
 miles 11 Cuervo  
 (distance) (direction) (nearest town)

WELL PURPOSE: home  
 (home, irrigation, municipal, industrial)

- WELL COMPLETION DATA:
- (1) diameter (inches) 2
  - (2) total depth (feet) 256
  - (3) static water level (feet) 16 below top of ground.
  - (4) casing galv. 246' (material) (depth)  
 2" (size) if telescope see back.
  - (5) screen 10' 246' (length) (depth to top)  
 2" (size) Stainless Steel (material)
  - (6) pump 1/2" 10 (HP) (yield gpm)  
 elec (type power)
  - (7) electric log no (yes or no)  
 (organization running log)
  - (8) how well bottom plugged BPI/Valve

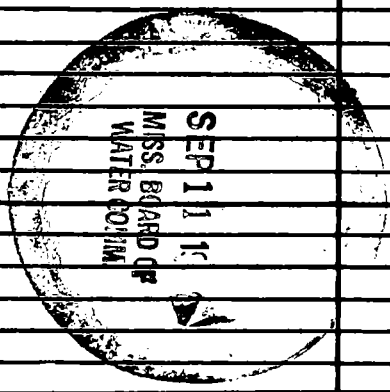

DRILLERS REMARKS:

If well telescopes please sketch and show depths.

GROUND LEVEL

X			

SECTION 8

Please indicate well location X.

ADDITIONAL INFORMATION

If more than one screen, show locations of each on sketch.