

**MISSISSIPPI
BOARD OF WATER COMMISSIONERS CODED**
416 North State Street
Jackson, Mississippi 39201

WATER WELL DRILLERS LOG

Harrison
023
8-21-68

8-21 1968 Sutter Well Works Harrison
date well completed firm name county well located

LANDOWNER: EMMETT NIOLET

Long Beach, Miss.

(mailing address)

WELL LOCATION:

sec. 11 T. 8 N. R. 12 E.
S W
1 miles N of Long Beach
(distance) (direction) (nearest town)

WELL PURPOSE: home
(home, irrigation, municipal, industrial)

WELL COMPLETION DATA:

- (1) diameter (inches) 2 x 4
- (2) total depth (feet) 295
- (3) static water level (feet) 14 below top of ground.
- (4) casing Galv., 295'
(material) (depth)
2" x 4" if telescope see back.
(size)
- (5) screen 10', 295'
(length) (depth to top)
2", stainless steel
(size) (material)
- (6) pump 1 10
(HP) (yield gpm)
elec
(type power)
- (7) electric log no
(yes or no)


(organization running log)
- (8) how well bottom plugged BPU

description of formations encountered

from to

<u>sand</u>	<u>0</u>	<u>30</u>
<u>clay</u>	<u>30</u>	<u>70</u>
<u>sand</u>	<u>70</u>	<u>85</u>
<u>clay</u>	<u>85</u>	<u>180</u>
<u>sand</u>	<u>180</u>	<u>205</u>
<u>clay</u>	<u>205</u>	<u>270</u>
<u>sand</u>	<u>270</u>	<u>295</u>

DRILLERS REMARKS:

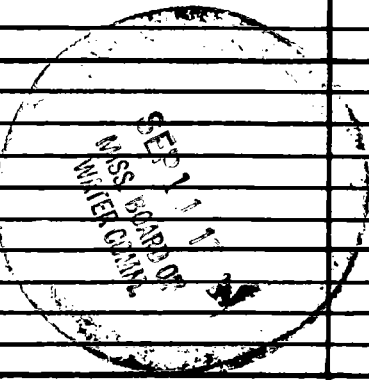

If well telescopes please sketch and show depths.

GROUND LEVEL

63' of 4" Galv.

222' of 2" Galv.

10' of 2" S.S. Struc.

	X		

SECTION 11

Please indicate well location X.

ADDITIONAL INFORMATION

vi

If more than one screen, show locations of each on sketch.