

Harrison
 024
 7-22-68

MISSISSIPPI
 BOARD OF WATER COMMISSIONERS
 416 North State Street
 Jackson, Mississippi 39201

CODED

WATER WELL DRILLERS' LOG

7-22-68 date well completed
 Lutter Well Works firm name
 Harrison county well located

LANDOWNER: Sam Michel
 1226 St. Ferdinand
 New Orleans Louisiana
 (mailing address)

description of formations encountered	from to	
Sand	0	15
Clay	15	158
Sand	158	173


WELL LOCATION:
 sec. 18 T. 8 N. R. 12 E.
 S W
 1/2 miles S of Cuevas
 (distance) (direction) (nearest town)

WELL PURPOSE: home
 (home, irrigation, municipal, industrial)

WELL COMPLETION DATA:

- (1) diameter (inches) 2
- (2) total depth (feet) 173
- (3) static water level (feet) 4 below top of ground.
- (4) casing galv. 168' (material) (depth)
 2" (size) if telescope see back.
- (5) screen 5' 168' (length) (depth to top)
 2" (size) Stainless Steel (material)
- (6) pump 1/3 10 (HP) (yield gpm)
 elec (type power)
- (7) electric log no (yes or no)
 (organization running log)
- (8) how well bottom plugged BPU value

DRILLERS REMARKS:

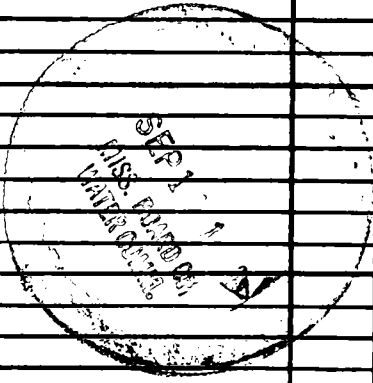

If well telescopes please sketch and show depths.

GROUND LEVEL

	X		

SECTION 18

Please indicate well location X.

ADDITIONAL INFORMATION

If more than one screen, show locations of each on sketch.