

Harrison  
 025  
 8-22-68

MISSISSIPPI  
 BOARD OF WATER COMMISSIONERS  
 416 North State Street  
 Jackson, Mississippi 39201

CODED

WATER WELL DRILLERS LOG

8-22 1968 Sutter Well Works Harrison  
 date well completed firm name county well located

LANDOWNER: E. A. Lindsey  
Munge Ave  
Pass Christian Miss  
 (mailing address)


description of formations encountered	from to	
<u>sand</u>	<u>0</u>	<u>80</u>
<u>clay - sand streaks</u>	<u>80</u>	<u>539</u>
<u>sand</u>	<u>539</u>	<u>579</u>

WELL LOCATION:  
 sec. 8 T. 8 R. 12  
                   S                  E  
   W  
 miles 1 1/2 (distance) direction N nearest town Georgetown

WELL PURPOSE: home  
 (home, irrigation, municipal, industrial)

WELL COMPLETION DATA:

- (1) diameter (inches) 2
- (2) total depth (feet) 579
- (3) static water level (feet) — below/above top of ground.
- (4) casing galv. (material), 579' (depth), 2" (size) if telescope see back.
- (5) screen 10' (length), 579' (depth to top), 2" (size), stainless steel (material)
- (6) pump unknown (HP), — (yield gpm)  
 (type power)
- (7) electric log no (yes or no)  
 (organization running log)
- (8) how well bottom plugged BP Velco

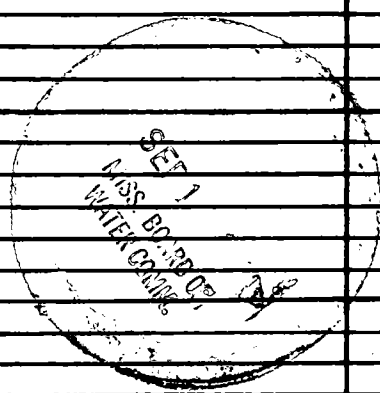

DRILLERS REMARKS: —

If well telescopes please sketch and show depths.

GROUND LEVEL

X			

SECTION 8

Please indicate well location X.

ADDITIONAL INFORMATION

If more than one screen, show locations of each on sketch.