

Harrison
027
9-10-68

MISSISSIPPI
 BOARD OF WATER COMMISSIONERS **CODED**
 416 North State Street
 Jackson, Mississippi 39201

WATER WELL DRILLERS LOG

9-10 1968 Lutter Well Works Harrison
 date well completed firm name county well located

LANDOWNER: Harry Babin
Rt 2 Box 27
Pass Christian, Miss.
 (mailing address)


description of formations encountered	from	to
	<u>sand</u>	<u>0</u>
<u>clay</u>	<u>27</u>	<u>166</u>
<u>sand</u>	<u>166</u>	<u>190</u>

WELL LOCATION:
 sec. 8 T. 4 S. R. 12 W.
1 miles E of Cuevas
 (distance) (direction) (nearest town)

WELL PURPOSE: home
 (home, irrigation, municipal, industrial)

- WELL COMPLETION DATA:
- diameter (inches) 2
 - total depth (feet) 190
 - static water level (feet) 17 below top of ground.
 - casing galv. 185'
 (material) (depth)
2" If telescope see back.
 (size)
 - screen 5' 185'
 (length) (depth to top)
2" stainless steel
 (size) (material)
 - pump unknown
 (HP) (yield gpm)
 (type power)
 - electric log no
 (yes or no)
 (organization running log)
 - how well bottom plugged BPU value

DRILLERS REMARKS:

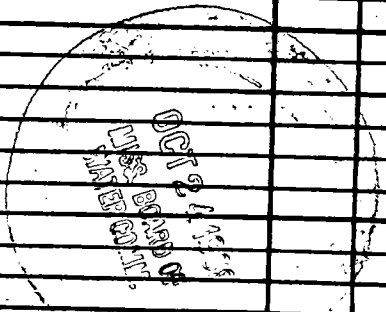

If well telescopes please sketch and show depths.

GROUND LEVEL

SECTION _____

Please indicate well location X.

ADDITIONAL INFORMATION

If more than one screen,
show locations of each on sketch.