

Harrison
 028
 10-16-68

MISSISSIPPI
 BOARD OF WATER COMMISSIONERS
 416 North State Street
 Jackson, Mississippi 39201

CODED

WATER WELL DRILLERS LOG

10-16-68 date well completed
 Lutter Well Works firm name
 Harrison county well located


LANDOWNER: Verde Lee Drevin
Cuevas
Driss
 (mailing address)

Description of formations encountered	from	to
<u>sand</u>	<u>0</u>	<u>43</u>
<u>clay</u>	<u>43</u>	<u>80</u>
<u>sand</u>	<u>80</u>	<u>106</u>
<u>clay</u>	<u>106</u>	<u>159</u>
<u>sand</u>	<u>159</u>	<u>179</u>

WELL LOCATION:
 sec 18 T 8 N S R 12 E W
 (distance) miles 10 (direction) of Cuevas (nearest town)

WELL PURPOSE: home
 (home, irrigation, municipal, industrial)

- WELL COMPLETION DATA:
- diameter (inches) 2
 - total depth (feet) 179
 - static water level (feet) 16 below above top of ground.
 - casing galv. 174'
 (material) (depth)
2"
 (size) if telescope see back.
 - screen 5' 174'
 (length) (depth to top)
2" stainless steel
 (size) (material)
 - pump 1/2 10
 (HP) (yield gpm)
elec
 (type power)
 - electric log no
 (yes or no)
 - (organization running log)
 - how well bottom plugged BP Valve

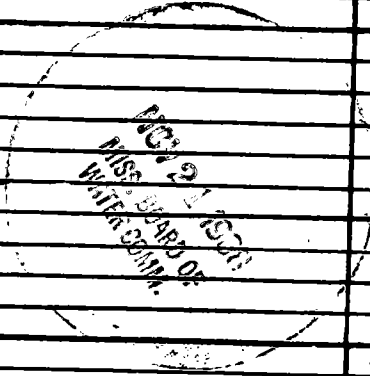

DRILLERS REMARKS:

If well telescopes please sketch and show depths.

GROUND LEVEL

100 0
100 10
100 20
100 30
100 40
100 50

100 60
100 70
100 80
100 90
100 100

SECTION _____

Please indicate well location X.

ADDITIONAL INFORMATION

If more than one screen, show locations of each on sketch.