

HAR. 033
1-22-62

WATER WELL DRILLERS LOG

F-302

Date: 1/22/62, 1962, Driller: H.A. Labrier County Harrison
(Name)

CODED


(1) Owner of Land: Jesse Ward
(Name)
Beatline Road Long Beach Miss.
(Address)
(2) Location: 1/4, 1/4, Sec. 3 T8S R12W
3 miles West of Long Beach
(distance) (direction) (Nearest Town)
(3) Topography: Flat
(Hilly) (Flat) (Level)
(4) Purpose of Well: Domestic
(Domestic Irrigation
Municipal, Industrial, Other)

Description & Color of Materials Sand, Clay, Red Clay, Shell, etc.	Thick- ness Feet	Depth Feet
Red clay	18	
White Sand	25	
Red clay	40	
Blue clay	367	
Good Sand Blue	60	
Blue clay	200	
Blue Sand	50	

Information upon completion of well:

(1) Diameter 2 inches.
(2) Total Depth 763 feet.
(3) Water Level flowing feet below top of ground.
(4) Cased to 753, Size 2"
(5) Screen: Size 60, Length 20
(6) Were any formations sealed against pollution?
 yes, no.

If YES depth of formation 450 feet
Why Sandy
Drillers Remarks: Good well.

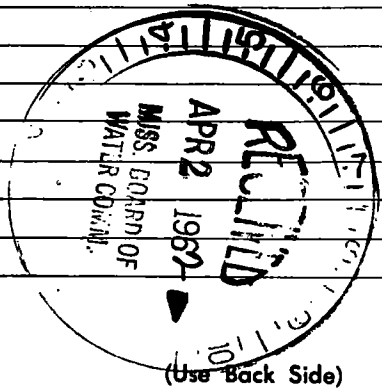

Well No.

Retain this copy for your office files.

Young we will start next
next time.

Fabrics will work
H. A. Johnson
Pt. 1, Box 185
Long Beach, Cal.