

HAR.

MISSISSIPPI BOARD OF WATER COMMISSIONERS

036

5-30-62

WATER WELL DRILLERS LOG

CODED

0-326

Date: 5-30, 1962, Driller: Better Well Works County Harrison

(Name)

(1) Owner of Land: B. F. Lindsay (Name) Long Beach, Miss. (Address)

(2) Location: SE 1/4, NW 1/4, Sec. 10 T85R12W 3 miles NW of Long Beach (distance) (direction) (Nearest Town)

(3) Topography: flat (Hilly) (Flat) (Level)


(4) Purpose of Well: domestic (Domestic Irrigation Municipal, Industrial, Other)

Description & Color of Materials Sand, Clay, Red Clay, Shell, etc.	Thick- ness Feet	Depth Feet
Surface sand	30	30
Clay	380	410
Sand	85	495
Clay	83	578
Sand	60	638

Information upon completion of well:

- (1) Diameter 2 inches.
- (2) Total Depth 638 feet.
- (3) Water Level 2 feet above ground.
- (4) Cased to all, Size 2"
- (5) Screen: Size 2", Length 20
- (6) Were any formations sealed against pollution?
yes, no.

If YES depth of formation
Why
Drillers Remarks:

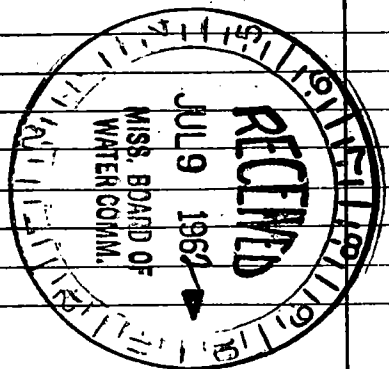

(Use Back Side)

Well No.

