

HAR.

0-37
6-1-62

WATER WELL DRILLERS LOG

0-327

Date: 6-1, 1962, Driller: Jutter Well Wks. County Harrison

CODED

(Name)

(1) Owner of Land: E. O. Hunt
(Name)
Long Beach, Miss.
(Address)

(2) Location: SW 1/4, SW 1/4, Sec. 15 T8S R12W
1 miles W, of Long Beach
(distance) (direction) (Nearest Town)

(3) Topography: flat
(Hilly) (Flat) (Level)

(4) Purpose of Well: domestic
(Domestic Irrigation
Municipal, Industrial, Other)

Description & Color of Materials Sand, Clay, Red Clay, Shell, etc.	Thick- ness Feet	Depth Feet
<u>Surface Sand</u>	<u>20</u>	<u>20</u>
<u>Clay</u>	<u>60</u>	<u>80</u>
<u>fine sand - mulch</u>	<u>220</u>	<u>300</u>
<u>Clay</u>	<u>148</u>	<u>448</u>
<u>Sand</u>	<u>60</u>	<u>508</u>

Information upon completion of well:

(1) Diameter 2 inches.

(2) Total Depth 508 feet.

(3) Water Level 4 feet below top of ground.

(4) Cased to all, Size 2" x 3".


(5) Screen: Size 2", Length 10'.

(6) Were any formations sealed against pollution?
_____ yes, X no.

If YES depth of formation _____

Why _____

Drillers Remarks: _____

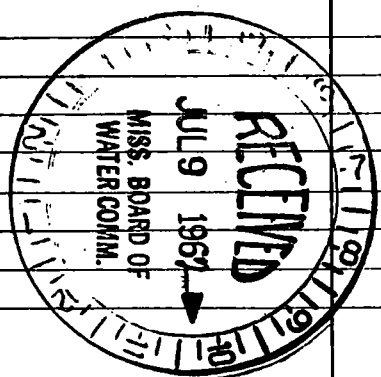

(Use Back Side)

Well No.



Handwritten text at the top of the page, possibly a header or title, which is mostly illegible due to fading and bleed-through.

Handwritten notes on the left side of the page, including what appears to be a list or series of entries.

Handwritten notes on the right side of the page, starting with the word "Handwritten" and continuing with several lines of text.

Handwritten notes on the left side of the page, continuing from the previous section.

Handwritten notes on the right side of the page, including a section that starts with "with..." and contains several lines of text.

Handwritten notes on the left side of the page, continuing the list or series of entries.

Handwritten notes on the right side of the page, including a section that starts with "EV's" and contains several lines of text.

