

HAR. 039
6-27-62

MISSISSIPPI BOARD OF WATER COMMISSIONERS

CODED

WATER WELL DRILLERS LOG

0-329

Date: 6-27, 1962, Driller: Sutter Well Works County Harrison
(Name)

(1) Owner of Land: PHILIP BABIN
(Name)
Pineville, Miss.
(Address)

(2) Location: SW 1/4, NE 1/4, Sec. 18 T85R12W
1 miles SW of Cuevas
(distance) (direction) (Nearest Town)

(3) Topography: flat
(Hilly) (Flat) (Level)

(4) Purpose of Well: domestic
(Domestic Irrigation
Municipal, Industrial, Other)

Description & Color of Materials Sand, Clay, Red Clay, Shell, etc.	Thick- ness Feet	Depth Feet
<u>Surface clay</u>	<u>19</u>	<u>19</u>
<u>sand</u>	<u>22</u>	<u>41</u>
<u>Clay</u>	<u>19</u>	<u>60</u>
<u>sand</u>	<u>28</u>	<u>88</u>
<u>Clay</u>	<u>272</u>	<u>360</u>
<u>sand</u>	<u>24</u>	<u>384</u>

Information upon completion of well:

(1) Diameter 2 inches.

(2) Total Depth 384 feet.

(3) Water Level 4 feet below top of ground.

(4) Cased to cell, Size 2"

(5) Screen: Size 2", Length 5'


(6) Were any formations sealed against pollution?
no

If YES depth of formation _____

Why _____

Drillers Remarks: _____

CODED

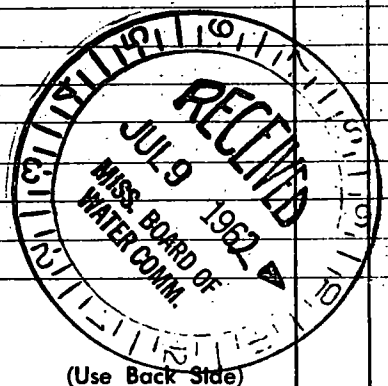

Well No.

