

042
7-31-62

CODED 0

WATER WELL DRILLERS LOG

Date: July 31, 1962, Driller: M & B Drilling Co. County Harrison
(Name)

(1) Owner of Land: David Alexander
(Name)
Johanna Rd. Long Beach, Miss.
(Address)

(2) Location: NW 1/4, NW 1/4, Sec. 16 SWR/2
2 miles NW of Long Beach
(distance) (direction) (Nearest Town)

(3) Topography: Flat
(Hilly) (Flat) (Level)

(4) Purpose of Well: Domestic
(Domestic Irrigation
Municipal, Industrial, Other)

Description & Color of Materials Sand, Clay, Red Clay, Shell, etc.	Thick- ness Feet	Depth Feet
Clay	15	15
White Sand	20	35
Blue Clay	225	260
Sand & Clay Breaks	20	280
Blue Clay	140	420
Sand & Clay Breaks	25	445
Grey Sand	29	469
Blue Clay	469	-

Information upon completion of well:

(1) Diameter 2 inches.

(2) Total Depth 467 feet.

(3) Water Level 1 feet below top of ground.

(4) Cased to 457, Size 2"


(5) Screen: Size 3/8 x 1/2", Length 10 FT.

(6) Were any formations sealed against pollution?
_____ yes, _____ no.

If YES depth of formation _____

Why _____

Drillers Remarks: _____

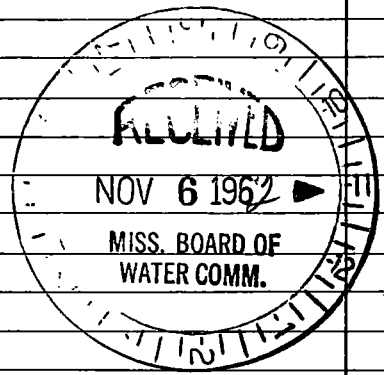

Well No.

(Use Back Side)

