

HAR. 0 A6

MISSISSIPPI BOARD OF WATER COMMISSIONERS


10-12-62

WATER WELL DRILLERS LOG

0  
CODED

Date: 10-12, 1962, Driller: Little Well Works County Harrison  
(Name)

(1) Owner of Land: <u>Mrs. Clem Lucier</u> (Name)	Description & Color of Materials Sand, Clay, Red Clay, Shell, etc.	Thick- ness Feet	Depth Feet
<u>Rt. 2 Long Beach Miss.</u> (Address)	<u>Sand</u>	<u>80</u>	<u>80</u>
(2) Location: <u>SW 1/4, NW 1/4, Sec. 10 T8S R12E</u>	<u>Clay</u>	<u>30</u>	<u>110</u>
<u>2</u> miles <u>NW</u> of <u>Long Beach</u> (distance) (direction) (Nearest Town)	<u>Sand</u>	<u>18</u>	<u>128</u>
(3) Topography: <u>flat</u> (Hilly) (Flat) (Level)	<u>Clay</u>	<u>274</u>	<u>402</u>
(4) Purpose of Well: <u>domestic</u> (Domestic Irrigation Municipal, Industrial, Other)	<u>Sand</u>	<u>28</u>	<u>430</u>
Information upon completion of well:			
(1) Diameter <u>2</u> inches.			
(2) Total Depth <u>430</u> feet.			
(3) Water Level <u>3</u> feet below top of ground.			
(4) Cased to <u>all</u> , Size <u>2"</u>			
(5) Screen: Size <u>2"</u> , Length <u>10'</u>			
(6) Were any formations sealed against pollution? <u>yes</u> , <input checked="" type="checkbox"/> <u>no</u> .			
If YES depth of formation _____			
Why _____			
Drillers Remarks: _____			
_____			
_____			
_____			

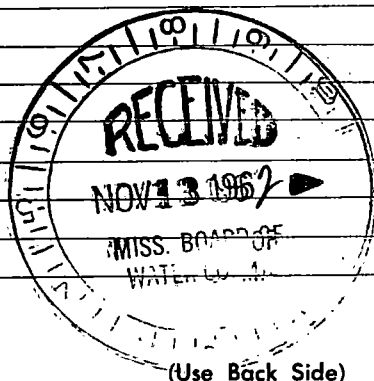

(Use Back Side)

Well No.

