

049  
10-27-62

WATER WELL DRILLERS LOG

CODED 0

Date: Oct. 27, 1962, Driller: M & B Drilling Co. County Harrison  
(Name)

(1) Owner of Land: D. J. Murphy  
(Name)  
R. B. Long Beach Johnson Rd.  
(Address)

(2) Location: NE 1/4, NW 1/4, Sec 13 T25N R24W  
2 1/2 miles NW, of Long Beach  
(distance) (direction) (Nearest Town)

(3) Topography: Flat  
(Hilly) (Flat) (Level)

(4) Purpose of Well: Domestic  
(Domestic Irrigation  
Municipal, Industrial, Other)

Description & Color of Materials Sand, Clay, Red Clay, Shell, etc.	Thick- ness Feet	Depth Feet
Clay	40	40
Blue clay	20	60
Sand & Clay Breake	50	110
Blue Clay	70	180
Sand & Clay Breake	40	220
Blue Clay	30	250
Grey Sand with yellow Clay mixed	60	310
Blue Clay	70	380
Sandstone	14	414
Blue Clay	11	425
Grey Sand	29	454

Information upon completion of well:

(1) Diameter 2 inches.

(2) Total Depth 457 feet.


(3) Water Level 1 feet below top of ground.

(4) Cased to 471, Size 2"

(5) Screen: Size 2" X 1/8" Length 10 FT.

(6) Were any formations sealed against pollution?  
\_\_\_\_\_ yes, \_\_\_\_\_ no.

If YES depth of formation \_\_\_\_\_  
Why \_\_\_\_\_  
Drillers Remarks: \_\_\_\_\_

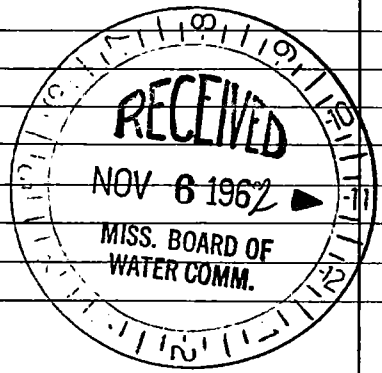

(Use Back Side)

Well No.

