

050
11-15-62

WATER WELL DRILLERS LOG

0
CODED

Date: 11-15, 1962, Driller: Sutter Well Works County Harrison
(Name)

(1) Owner of Land: Homer Magee
(Name)
Long Beach, Miss.
(Address)

(2) Location: SW 1/4, SW 1/4, Sec. 1 T85R12W
1 miles N of Long Beach
(distance) (direction) (Nearest Town)

(3) Topography: flat
(Hilly) (Flat) (Level)

(4) Purpose of Well: domestic
(Domestic Irrigation
Municipal, Industrial, Other)

Description & Color of Materials Sand, Clay, Red Clay, Shell, etc.	Thick- ness Feet	Depth Feet
Clay	20	20
sand	43	63
Clay	62	125
sand	50	175
Clay	31	206
sand	92	298
Clay	112	390
sand	80	470

Information upon completion of well:

(1) Diameter 2 inches.

(2) Total Depth 470 feet.

(3) Water Level 4 feet above top of ground.

(4) Cased to all, Size 2"


(5) Screen: Size 2", Length 10'

(6) Were any formations sealed against pollution?
no yes, no.

If YES depth of formation _____

Why _____

Drillers Remarks: _____

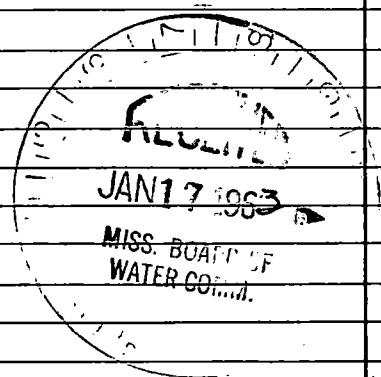

CODED

(Use Back Side)

Well No.

