

HAR. 0-51
1-17-63

WATER WELL DRILLERS LOG

0

Date: 1-17, 1963, Driller: Sutter Well Works County Madison **CODED**
(Name)

- (1) Owner of Land: J.E. Stevens
(Name)
Greefport Miss.
(Address)
- (2) Location: SE 1/4, SW 1/4, Sec. 3 T85R12W
2 miles N of Lou Beach
(distance) (direction) (Nearest Town)
- (3) Topography: flat
(Hilly) (Bar) (Level)
- (4) Purpose of Well: domestic
(Domestic Irrigation
Municipal, Industrial, Other)

Description & Color of Materials Sand, Clay, Red Clay, Shell, etc.	Thick- ness Feet	Depth Feet
<u>Sand</u>	<u>57</u>	<u>57</u>
<u>Clay</u>	<u>106</u>	<u>163</u>
<u>Sand</u>	<u>15</u>	<u>178</u>
<u>Clay</u>	<u>97</u>	<u>275</u>
<u>sand</u>	<u>15</u>	<u>290</u>

Information upon completion of well:


- (1) Diameter 2 inches.
- (2) Total Depth 290 feet.
- (3) Water Level 5 feet below top of ground.
- (4) Cased to all, Size 2"
- (5) Screen: Size 2", Length 10'
- (6) Were any formations sealed against pollution?
no

If YES depth of formation _____
Why _____

Drillers Remarks: _____

CODED

CODED

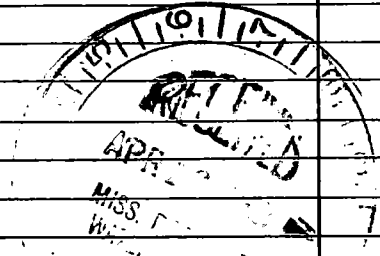

Well No.

(Use Back Side)

[The page contains extremely faint and illegible text, likely bleed-through from the reverse side of the document. The text is scattered across the page and does not form any recognizable words or sentences.]