

HAR. 3
053
2-22-63

WATER WELL DRILLERS LOG

CODED


Date: 2-22, 1963, Driller: Little Well Works County Harrison
(Name)

(1) Owner of Land:	Description & Color of Materials <small>Sand, Clay, Red Clay, Shell, etc.</small>	Thick-ness Feet	Depth Feet
<u>Little Zion Baptist Church</u> (Name)	<u>Sand</u>	<u>105</u>	<u>105</u>
<u>Long Beach, Miss.</u> (Address)	<u>Clay</u>	<u>325</u>	<u>430</u>
(2) Location: <u>NE 1/4, SW 1/4, Sec. 10 T85R12W</u>	<u>Sand</u>	<u>45</u>	<u>475</u>
<u>2</u> miles <u>N</u> , of <u>Long Beach</u> (distance) (direction) (Nearest Town)			
(3) Topography: <u>flat</u> (Hilly) (Flat) (Level)			
(4) Purpose of Well: <u>Church</u> <small>(Domestic Irrigation Municipal, Industrial, Other)</small>			

Information upon completion of well:

(1) Diameter 2 inches.
(2) Total Depth 475 feet.
(3) Water Level 5 feet below top of ground.
(4) Cased to all, Size 2"
(5) Screen: Size 2", Length 10'
(6) Were any formations sealed against pollution?
_____ yes, no.

If YES depth of formation _____
Why _____
Drillers Remarks: _____

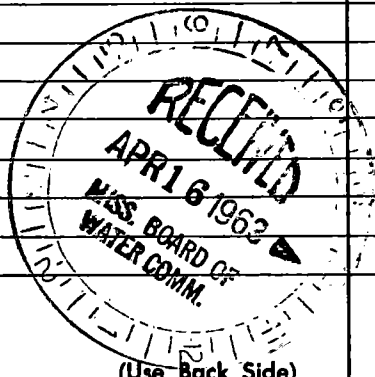

Well No.

Handwritten text at the top of the page, including a date and possibly a name.

Main body of handwritten text, appearing to be a list or a series of entries.

Handwritten word, possibly "Journal" or "Diary".

Small handwritten number or symbol.

Handwritten text, possibly a signature or a name.

Handwritten text, possibly a name or a title.

Bottom section of handwritten text, possibly a conclusion or a signature.